


CERTIFIED RECORD OF LAND CORNER MONUMENTATION

History of original corner establishment: Corner was originally established by W. B. Barr under Contract No. 503 in July, 1884. The original notes state that a 4' long x 4" diameter post was set 24" in ground from which:

- A 6" Pine bears S 45° W 100 LKS marked 1/4 S BT.
- A 20" Pine bears S 40° E 45LKS marked 1/4 S BT.

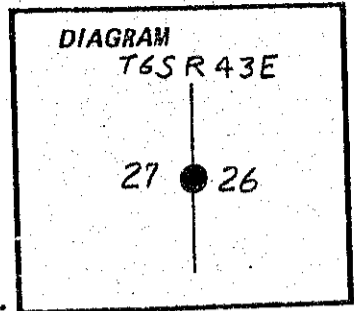

No evidence of subsequent re-monumentation was found in County Records.

Description of corner evidence found:


None.

After a thorough search for the corner I set it by single proportion measure between the Southeast and Northeast corner of Section 27, both found corners.

Description of monument and accessories I established to perpetuate the original location of this corner: At the calculated corner position I set a 2" x 30" iron pipe with brass cap 22" in the ground and surrounded with a mound of stone marked:

From which:

- A 23" Ponderosa Pine bears S 79° W for 29.5 feet, scribed 1/4 S27 BT.
- A 24" Ponderosa Pine bears S 76 1/2° E for 34.7 feet, scribed 1/4 S26 BT.
- Both BT's have a lower blaze scribed BT with a brass washer stamped PLS 1106 nailed flush. Attached signs 54-3 and painted red ring around each BT.
- Set steel fence post with sign 54-9 attached next to monument.

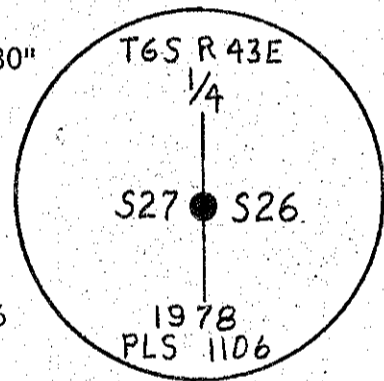

Witness: Les Wilson

Used magnetic compass with 20 1/2° E declination and measured to center of root crown on BT's with steel tape.

REGISTERED PROFESSIONAL LAND SURVEYOR

William R. Wells

OREGON
JULY 22, 1977
WILLIAM R. WELLS
1106

11-1-78

Office of..... County of.....
 State of..... I hereby certify that the within instrument was filed in this office
 for record on the..... day of....., 19.....
 by.....
 (COUNTY OFFICIAL) (DEPUTY)