


CERTIFIED RECORD OF LAND CORNER MONUMENTATION

History of original corner establishment: Corner was originally located by W. B. Barr under Contract No. 388 in August, 1881. The original notes state that a marked slate stone was set for the corner from which:
 A 30" Pine bears North 7 LKS.
 A 36" Pine bears South 6 LKS.

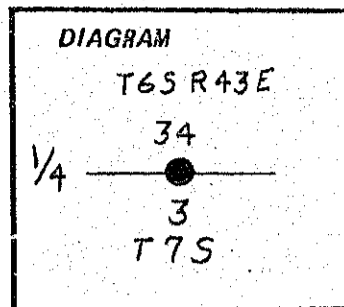


No record of subsequent re-monumentation found in County Records.

Description of corner evidence found:

None.

After a thorough search for corner evidence I set the corner by single proportion measurement along the township line from found Southeast corner of Section 36 to the found Southwest corner of Section 34.

Description of monument and accessories I established to perpetuate the original location of this corner: At the calculated corner position is set a 2" x 30" iron pipe with a 2 1/2" brass cap 15" in the ground with a mound of earth to within 6" of cap marked:

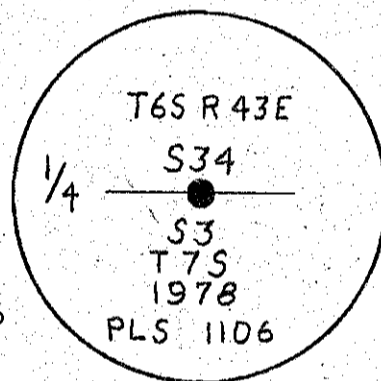

From which:

A 15" Ponderosa Pine bears N 34° E for 33.9 feet, scribed 1/4 S34 BT.
 A 9 1/2" Red Fir bears S 11° E for 26.4 feet, scribed 1/4 S3 BT.
 Both BT's have a lower blaze scribed BT with a brass washer stamped PLS 1106 nailed flush. Attached sign 54-3 and painted red ring around BT's.
 Set a steel fence post with sign 54-9 attached by the monument.

Witness: Les Wilson

Used magnetic compass with 20 1/2° E declination and measured to center of root crown on BT's with steel tape.

REGISTERED
 PROFESSIONAL
 LAND SURVEYOR

William R. Wells

OREGON
 JULY 22, 1977
 WILLIAM R. WELLS
 1106

11-1-78

Office of..... County of.....
 State of..... I hereby certify that the within instrument was filed in this office
 for record on the..... day of....., 19.....
 by

(COUNTY OFFICIAL)

(DEPUTY)

FILED Nov. 3, 1978
 BAKER COUNTY SURVEYOR
 SURVEY NO. 6-43-16