


CERTIFIED RECORD OF LAND CORNER MONUMENTATION

History of original corner establishment: Corner was originally established by W. B. Barr under Contract No. 388 in August, 1881. The original notes state that a 4" x 4' post was set 18" in the ground from which:
A 6" Fir bears N 20° W for 16 LKS.
A 5" Fir bears S 55° W for 20 LKS.

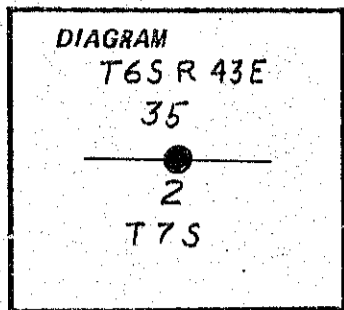


No record of subsequent re-monumentation found in County Records.

Description of corner evidence found:
None.

After a thorough search for original corner evidence I set the corner by single proportion measure along the township line from the found Southeast corner of Section 36 to the found Southwest corner of Section 34.

Description of monument and accessories I established to perpetuate the original location of this corner: At the calculated corner position I set a 2" x 30" iron pipe with 2 1/2" brass cap marked:
Monument set 24" in ground with mound of stones to cap.

From which:
A 25 1/2" Red Fir bears N 26 1/2° E for 37.0 feet, scribed 1/4 S35 BT.
An 18 1/2" Red Fir bears S 70 1/2° E for 31.1 feet, scribed 1/4 S2 BT.
Both BT's have a lower blaze scribed BT with a brass washer scribed PLS 1106 nailed flush. Attached sign 54-3 and painted red ring around BT's.
Set a steel fence post with sign 54-9 attached next to monument.

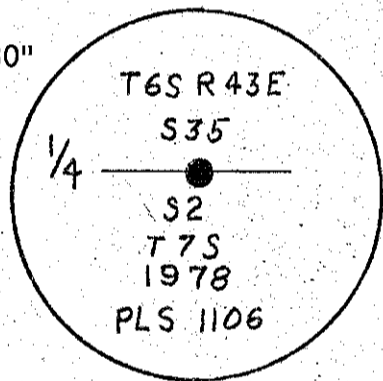

Witness: Les Wilson

Used magnetic compass with 20 1/2° E declination and measured to center of root crown on BT's with steel tape.

REGISTERED
PROFESSIONAL
LAND SURVEYOR

William R. Wells
OREGON
JULY 22, 1977
WILLIAM R. WELLS
1106

11-1-78

Office of..... County of.....
State of..... I hereby certify that the within instrument was filed in this office
for record on the..... day of....., 19.....
..... by

(COUNTY OFFICIAL)

(DEPUTY)

Form R6-7100-57 (9/71)

☆ GPG-798-276

FILED Nov. 3, 1978
BAKER COUNTY SURVEYOR
SURVEY NO. 6-43-17