


CERTIFIED RECORD OF LAND CORNER MONUMENTATION

History of original corner establishment: Corner was originally established by W. B. Barr under Contract No. 503 in July, 1884. The original notes state that a granite rock 14" x 10" x 5" x 10" was set for the corner from which:

- A 5" fir bears N 70 $\frac{1}{2}$ ° E 40 LKS marked T6S R43E S23 BT.
- A 36" Pine bears N 42° W 25 LKS marked T6S R43E S22 BT.
- A 20" Pine bears S 31° E 78 LK marked T6S R43E S26 BT.

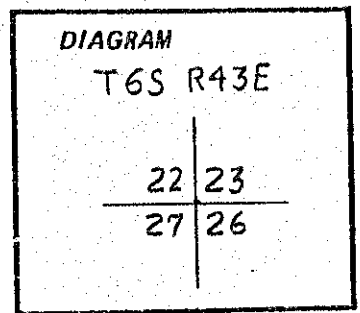

No evidence of subsequent re-monumentation found in County Records.


Description of corner evidence found:

- Found 14" x 10" x 5" x 10" granite stone set in ground from which:
- A stumphole bears N 70 $\frac{1}{2}$ ° E for 26.4 feet.
- A 41" Ponderosa Pine bears N 33 $\frac{1}{2}$ ° W for 16.5 feet with scribing.
- A 36" Ponderosa Pine bears S 51° W for 46.2 feet with scribing.
- A 20" Ponderosa Pine bears S 31° E for 51.5 feet with scribing.

Description of monument and accessories I established to perpetuate the original location of this corner: At the corner position I set a 2" x 30" iron pipe with brass cap 24 inches in the ground and surrounded with mound of stone marked:

From which:

- A 16" Ponderosa Pine bears N 7 $\frac{1}{2}$ ° E for 58.5 feet, scribed T6S R43E S23 BT.
- Buried original stone underground beside new monument.
- Set steel fence post with sign 54-4 attached next to new monument.
- New BT has a lower blaze scribed BT with a brass washer stamped PLS 1106 nailed flush.
- Attached signs 54-3 and painted a red ring around all BT's.

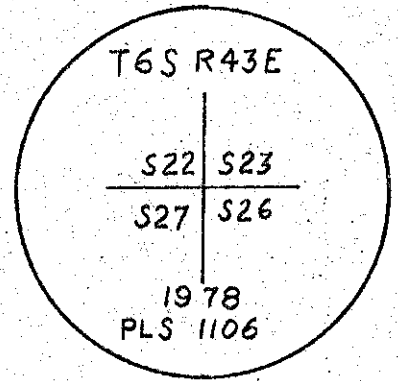

Witness: Les Wilson

Used magnetic compass with 20 $\frac{1}{2}$ ° E declination and measured to center of root crown on BT's with steel tape.

REGISTERED  
PROFESSIONAL  
LAND SURVEYOR

*William R. Wells*

OREGON  
JULY 22, 1977  
WILLIAM R. WELLS  
1106

11-1-78

Office of..... County of.....  
State of..... I hereby certify that the within instrument was filed in this office  
for record on the..... day of....., 19.....  
..... by .....  
(COUNTY OFFICIAL) (DEPUTY)

FILED Nov. 3, 1978  
BAKER COUNTY SURVEYOR  
SURVEY NO. 6-43-20