


CERTIFIED RECORD OF LAND CORNER MONUMENTATION

History of original corner establishment:

Corner was originally established by W. B. Barr under Contract No. 503 in July 1884. The original notes call for a limestone 18" x 16" x 15" above ground from which:
A 20" pine bears N 73° W 65 LIC marked 1/4 S BT
An 18" pine bears N 56° E 46 LIC marked 1/4 S BT

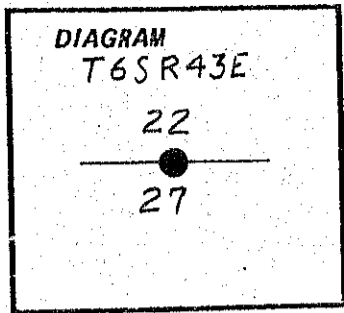

No record of subsequent re-monumentation found in County Records.
or any records.

Description of corner evidence found:

None.

After a thorough search of the area I set the South 1/4 of Section 22 by single proportion measure between the found SW and SE corners of Section 22.


Description of monument and accessories I established to perpetuate the original location of this corner. At the calculated corner position I set a 2" x 30" iron pipe with brass cap 28" in the ground with a mound of stones to cap marked:

From which: An 11" Ponderosa Pine bears N 10° W for 38.1 feet, scribed 1/4 S22 BT.

A 12" Red Fir bears S 36° E for 60.0 feet, scribed 1/4 S27 BT.

BT's set have a lower blaze scribed BT with a brass washer stamped PLS 1106 nailed flush. Attached sign 54-3 and painted a red ring around BT's.

Set steel fence post with sign 54-9 attached next to monument.

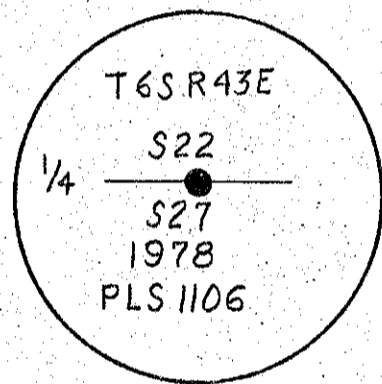

Witness: Les Wilson

Used magnetic compass with 20 1/2° E declination and measured to center of root crown on BT's with steel tape.

REGISTERED
PROFESSIONAL
LAND SURVEYOR

William R. Wells

OREGON
JULY 22, 1977
WILLIAM R. WELLS
1106

11-1-78

Office of..... County of.....
State of..... I hereby certify that the within instrument was filed in this office
for record on the..... day of....., 19.....
..... by

(COUNTY OFFICIAL)

(DEPUTY)

FILED Nov. 3, 1978

BAKER COUNTY SURVEYOR
SURVEY NO. 6-43-22