


CERTIFIED RECORD OF LAND CORNER MONUMENTATION

History of original corner establishment: Corner was originally established by W. B. Barr under Contract No. 503 in July, 1884. The original notes state that a granite rock 12" x 6" x 5" x 8" was set for the corner from which:

- A 10" Tamarack bears N 37° E 75 LK marked T6S R43E S28 BT.
- An 8" Fir bears N 48½° E 73 LK marked T6S R43E S29 BT.
- A 7" Fir bears S 60½° W 21 LK marked T6S R43E S32 BT.
- A 10" Tamarack bears S 64° E 30 LK marked T6S R43E S33 BT.

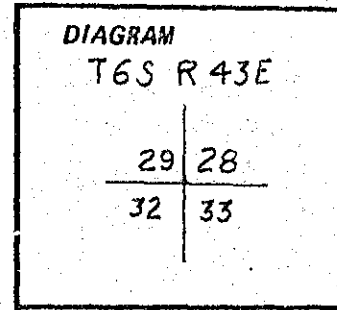

No evidence of subsequent re-monumentation found in County Records.

Description of corner evidence found:


No evidence of corner stone found.

A Tamarack bears N 37° E 75 LK with scribing --- R43E S28 BT.
BT's in Sections 29 and 32 probably destroyed by canal construction.
Re-established corner S 37° W 75LK from stump of found 12" Tamarack.

Description of monument and accessories I established to perpetuate the original location of this corner: At the corner position I set a 2" x 30" iron pipe with brass cap 20" in the ground and surrounded with a mound of earth, cap is marked:

From which:

- An 11½" Tamarack bears S 25½° E for 50.2 feet, scribed T6S R43E S33 BT.
 - A 19" Tamarack bears N 86½° W for 52.4 feet, scribed T6S R43E S29 BT.
 - An 11½" Lodgepole Pine bears N 14½° E for 21.4 feet, scribed T6S R43E S28 BT.
 - A 12" Tamarack bears S 33½° W for 42.1 feet, scribed T6S R43E S32 BT.
- All new BT's have a lower blaze scribed BT with a brass washer stamped PLS 1106 nailed flush. Attached sign 54-3 to new BT's and painted a red ring around all BT's.
Attached sign 54-4 to steel fence post and set by new monument.

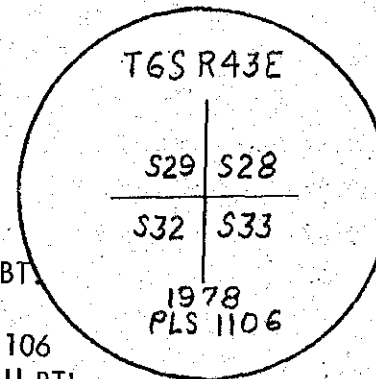

Witness: Les Wilson

Used magnetic compass with 20½° E declination and measured to center of root crown on BT's with steel tape.

REGISTERED
PROFESSIONAL
LAND SURVEYOR

William R. Wells

OREGON
JULY 22, 1977
WILLIAM R. WELLS
1106

11-1-78

Office of..... County of.....
State of..... I hereby certify that the within instrument was filed in this office
for record on the..... day of....., 19.....

..... by
(COUNTY OFFICIAL) (DEPUTY)

Form R6-7100-57 (9/71)

*GPO--798-276

FILED Nov. 3, 1978
BAKER COUNTY SURVEYOR
SURVEY NO. 6-43-23