


CERTIFIED RECORD OF LAND CORNER MONUMENTATION

History of original corner establishment:

Corner originally established by W. B. Barr under Contract No. 388 in August, 1881. The original notes state that a marked basalt rock 20" x 12" x 5" was set for the corner and a mound of stones was raised as per instructions:

From the corner a 3" fir bears South for 15 LKS

No record of subsequent re-monumentation found in county records.

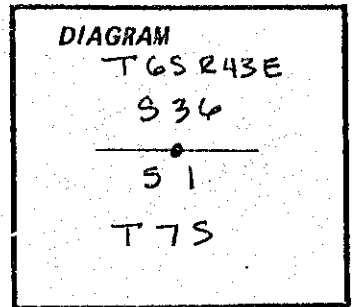

Description of corner evidence found: None.

After a thorough search for original corner evidence I set the corner by single proportion measure along the township line from the found Southeast corner of Section 36 to the found Southwest corner of Section 34.

Description of monument and accessories I established to perpetuate the original location of this corner:

At the calculated corner position I set a 2" x 30" iron pipe with brass cap 15" in the ground marked:


Surrounded monument with stones to within 2" of top of cap from which:

A 16" Red Fir bears N 10 1/2° E for 110.9 feet, scribed 1/4 S36 BT.

A 32" Red Fir bears S 60 1/2° W for 45.6 feet, scribed 1/4 S1 BT.

Both BT's have a lower blaze scribed BT with a brass washer stamped PLS 1106 nailed flush. Attached sign 54-3 and painted a red ring around BT's.

Set a steel fence post with sign 54-9 attached on section line next to monument.

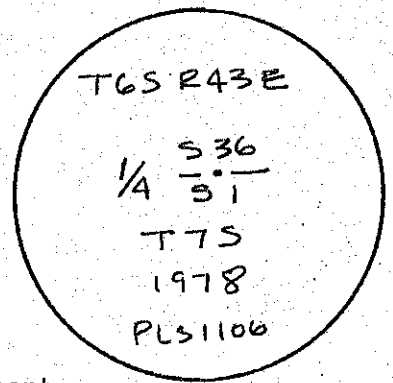

Witness: Les Wilson

Used magnetic compass with 19 1/2° E declination and measured to center of root crown with steel tape.

REGISTERED
PROFESSIONAL
LAND SURVEYOR

William R. Wells

OREGON
JULY 22, 1977
WILLIAM R. WELLS
1106

11-1-78

Office of..... County of.....

State of..... I hereby certify that the within instrument was filed in this office for record on the..... day of....., 19.....

..... by.....
(COUNTY OFFICIAL) (DEPUTY)

FILED Nov. 3, 1978
BAKER COUNTY SURVEYOR
SURVEY NO. 6-43-24