


CERTIFIED RECORD OF LAND CORNER MONUMENTATION

History of original corner establishment: Corner was originally established by W. B. Barr under Contract No. 388 in August, 1881. The original notes state that a marked basalt stone 14" x 8" x 6" was set for corner from which:

- A Fir 4" in diameter bears N 39° E 38 LK.
- A Fir 6" in diameter bears S 57° W 19 LK.
- A Fir 15" in diameter bears N 21° W 48 LK.
- A Fir 12" in diameter bears S 58° E 70 LK.

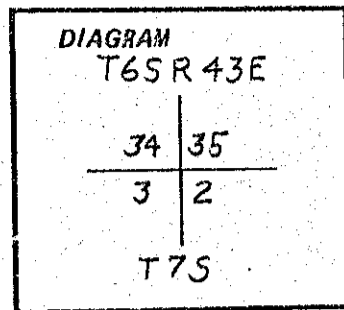


No record of subsequent re-monumentation found in County Records.

Description of corner evidence found:

None.

After a thorough search for original corner evidence I set the corner by single proportion measure along the township line from the found Southeast corner of Section 36 to the found Southwest corner of Section 34.

Description of monument and accessories I established to perpetuate the original location of this corner. At the calculated corner position I set a 2" x 30" iron pipe with brass cap 10" in the ground and surrounded with a mound of stone to cap. Monument marked:

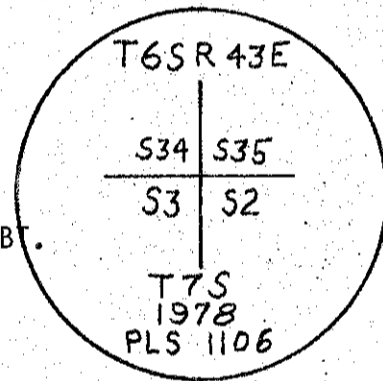

From which:

- An 11" Ponderosa Pine bears N 81½° W for 32.2 feet, scribed T6S R43E S34 BT.
  - An 8½" Red Fir bears N 24° E for 26.5 feet, scribed T6S R43E S35 BT.
  - A 9½" Red Fir bears S 36° E for 13.8 feet, scribed T7S R43E S2 BT.
  - A 14" Red Fir bears S 45½° W for 68.4 feet, scribed T5S R43E S3 BT.
- All BT's have a lower blaze scribed BT with a brass washer stamped PLS 1106 nailed flush. Attached sign 54-3 and painted a red ring around BT's. Set a steel fence post with sign 54-9 attached next to monument.

Witness: Les Wilson

Used magnetic compass with 20½° E declination and measured to center of root crown on BT's with steel tape.

REGISTERED  
PROFESSIONAL  
LAND SURVEYOR

*William R. Wells*

OREGON  
JULY 22, 1977  
WILLIAM R. WELLS  
1106

11-1-78

Office of..... County of.....

State of..... I hereby certify that the within instrument was filed in this office for record on the..... day of....., 19.....

..... by .....

(COUNTY OFFICIAL)

(DEPUTY)

FILED Nov. 3, 1978  
BAKER COUNTY SURVEYOR  
SURVEY NO. 6-43-25