


CERTIFIED RECORD OF LAND CORNER MONUMENTATION

History of original corner establishment: Corner was originally established by W. B. Barr under Contract No. 503 in July, 1884. The original notes state that a 4' long by 4" diameter post was set 24" in ground for corner from which:

- A 12" Fir bears S 35 $\frac{1}{2}$ ° W 12 LK marked 1/4 S BT.
- A 5" Fir bears N 20° E 15 LK marked 1/4 S BT.

No evidence of subsequent re-monumentation found in County Records.

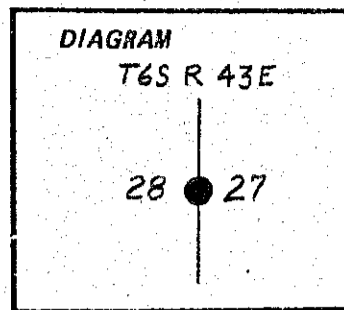

Description of corner evidence found:


None.

After a thorough search of the area I set the corner by single proportion measure between the found Southwest and Northwest corners of Section 27.

Description of monument and accessories I established to perpetuate the original location of this corner: At the calculated corner position I set a 2" x 30" iron pipe with brass cap 15" in the ground until a large root was hit. Surrounded monument with mound of earth to within 6" of the cap. Cap is marked:

From which:

- A 14" Red Fir bears S 6° W for 1.7 feet, scribed 1/4 S28 BT.
- An 11" Red Fir bears S 72° E for 12.0 feet, scribed 1/4 S27 BT.
- Both BT's have a lower blaze scribed BT with a brass washer stamped PLS 1106 nailed flush. Attached signs 54-3 and painted a red ring around each BT.
- Set a steel fence post with sign 54-9 attached next to monument.

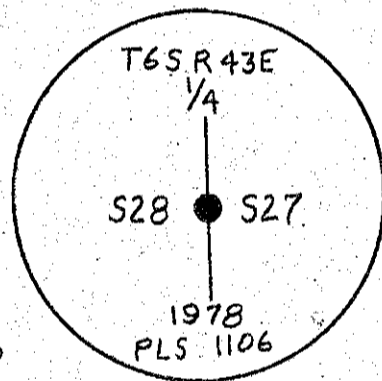

Witness: Les Wilson

Used magnetic compass with 20 $\frac{1}{2}$ ° E declination and measured to center of root crown on BT's with steel tape.

REGISTERED
PROFESSIONAL
LAND SURVEYOR
William R. Wells
OREGON
JULY 22, 1977
WILLIAM R. WELLS
1106
11-1-78

Office of..... County of.....
State of..... I hereby certify that the within instrument was filed in this office
for record on the..... day of....., 19.....
..... by.....
(COUNTY OFFICER) (DEPUTY)