


CERTIFIED RECORD OF LAND CORNER MONUMENTATION

History of original corner establishment: Corner was originally established by W. B. Barr under Contract No. 388 in August 1881. The original notes state that a marked basalt rock 20" x 18" x 6" was set from which:
 A 24" Pine bears N 3° E 47 LK.
 A 6" Pine bears S 34° E 93 LK.
 A 12" Fir bears N 73° W 26 LK.
 A 6" Fir bears S 70½° W 45 LK.

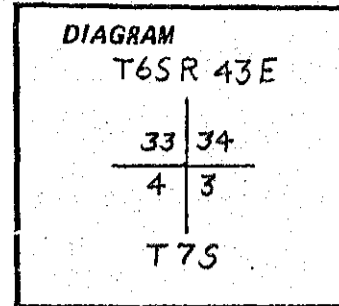


No record of subsequent re-monumentation found in County Records.

Description of corner evidence found:

No evidence of original corner stone found.

A 19" Ponderosa Pine bears S 34° E for 62.0 feet with healed blaze.
 A stump hole for a 27" Ponderosa Pine snag bears N 3° E for 31.0 feet.
 A down 27" Ponderosa Pine snag bears S 71° W for 40 feet + with scribing T6S --- S3+.
 A 28" Red Fir bears N 67½° W for 17.1 feet with healed blaze.
 A 21½" Red Fir bears S 70½° W for 29.7 feet with healed blaze.

Description of monument and accessories established to perpetuate the original location of this corner. At the corner position I set a 2" x 30" iron pipe with brass cap 15" in the ground and surrounded with a mound of stones to within 6" of the cap marked:

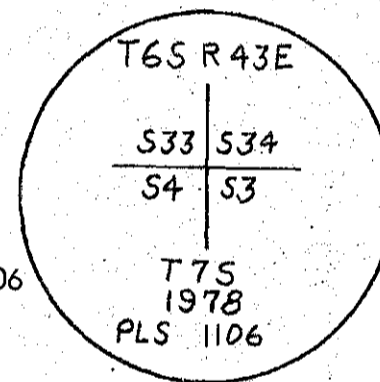

From which:

A 15" Red Fir bears N 16½° E for 40.8 feet, scribed T6S R43E S34 BT.
 The new BT has a lower blaze scribed BT with a brass washer stamped PLS 1106 nailed flush. Attached sign 54-3 and painted a red ring around each BT.
 Set a steel fence post with a 54-4 sign attached near monument.

Witness: Les Wilson

Used magnetic compass with 20½° E declination and measured to center of root crown on BT's with steel tape.

REGISTERED
PROFESSIONAL
LAND SURVEYOR

William R. Wells

OREGON
JULY 22, 1977
WILLIAM R. WELLS
1106

11-1-78

Office of..... County of.....
 State of....., I hereby certify that the within instrument was filed in this office
 for record on the..... day of....., 19.....
 by
 (COUNTY OFFICIAL) (DEPUTY)

Form R6-7100-57 (9/71)

☆ GPO - 798-276

FILED Nov. 3, 1978
 BAKER COUNTY SURVEYOR
 SURVEY NO. 6-43-27