


CERTIFIED RECORD OF LAND CORNER MONUMENTATION

History of original corner establishment: Corner was originally established by W. B. Barr under Contract No. 503 in July, 1884. The original notes state that a 4' long by 4" diameter post was set 24" in the ground for the corner from which:
A 12" Black Pine bears N 87° W 8 LKS marked 1/4 S BT.
A 7" Black Pine bears S 85° W 9 LKS marked 1/4 S BT.

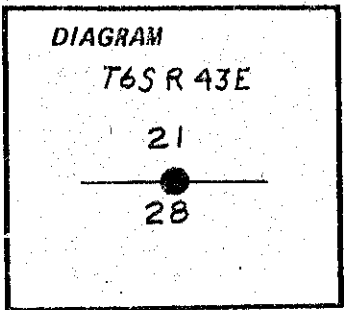


No evidence of subsequent re-monumentation found in County Records.

Description of corner evidence found:

None.

After a thorough search of the area I set the corner by single proportion measure between the found Northeast and Northwest corners of Section 28.

Description of monument and accessories I established to perpetuate the original location of this corner: At the calculated corner position I set a 2" x 30" iron pipe with brass cap 24" in the ground marked:

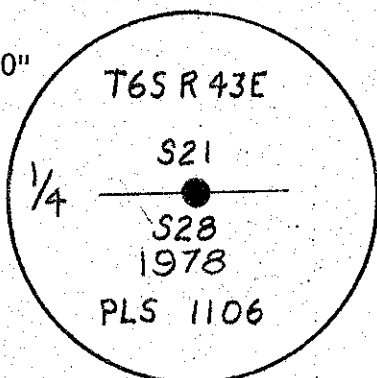

From which:

A 9 1/2" Tamarack bears N 47 1/2° E for 11.9 feet, scribed 1/4 S21 BT.
A 9" Tamarack bears S 15° E for 16.0 feet, scribed 1/4 S28 BT.
Both BT's have a lower blaze scribed BT with a brass washer stamped PLS 1106 nailed flush. Attached sign 54-3 and painted a red ring around each BT.
Set a steel fence post with sign 54-9 attached next to the monument.

Witness: Les Wilson

Used magnetic compass with 20 1/2° E declination and measured to center of root crown on BT's with steel tape.

REGISTERED
PROFESSIONAL
LAND SURVEYOR

William R. Wells

OREGON
JULY 22, 1977
WILLIAM R. WELLS
1106

11-1-78

Office of..... County of.....

State of..... I hereby certify that the within instrument was filed in this office for record on the..... day of....., 19.....

..... by

(COUNTY OFFICIAL)

(DEPUTY)

FILED Nov, 3, 1978
BAKER COUNTY SURVEYOR
SURVEY NO. 6-43-28