


CERTIFIED RECORD OF LAND CORNER MONUMENTATION

History of original corner establishment:

No record of corner being established found in County Surveyors Office.

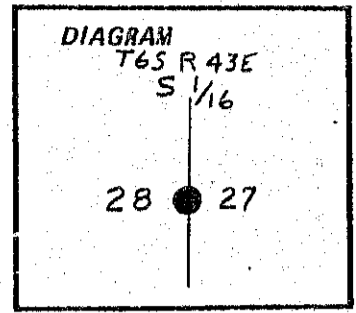


Description of corner evidence found:

None.

*A 6' tall iron rod bears S 80° E for 5.6 feet set by property owner.

Description of monument and accessories established to perpetuate the original location of this corner. Set 2" x 30" iron pipe with brass cap marked: Set monument 6" in ground to solid rock and surrounded with a mound of stone to within 6" of cap from which:
 A 24" Ponderosa Pine bears N 13½° E for 16.3 feet, scribed S 1/16 S27 BT.
 An 11" Ponderosa Pine bears N 74° W for 57.2 feet, scribed S 1/16 S28 BT.
 Both BT's have a lower blaze scribed BT with a brass washer stamped PLS 1106 nailed flush. Attached signs 54-3 and painted a red ring around each BT.
 Set a steel fence post on property line by monument and attached signs 54-2 and 54-9.

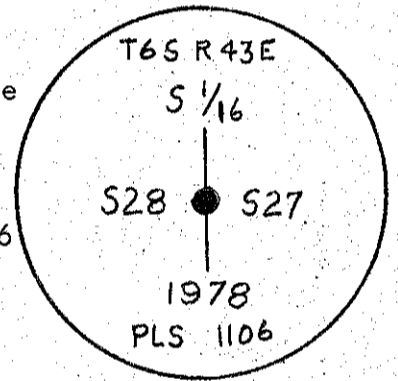

Witness: Les Wilson

Used magnetic compass with 20½° E declination and measured to center of root crown on BT's with steel tape.

REGISTERED
 PROFESSIONAL
 LAND SURVEYOR

William R. Wells

OREGON
 JULY 22, 1977
 WILLIAM R. WELLS
 1106

11-1-78

Office of..... County of.....

State of..... I hereby certify that the within instrument was filed in this office for record on the..... day of....., 19.....

(COUNTY OFFICIAL)

(DEPUTY)

FILED Nov. 3, 1978
 BAKER COUNTY SURVEYOR
 SURVEY NO. 6-43-29