


CERTIFIED RECORD OF LAND CORNER MONUMENTATION

History of original corner establishment:

No record of corner being established found in County Surveyors Office.

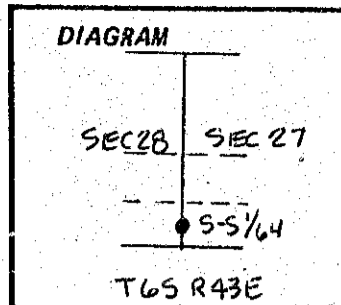

Description of corner evidence found: None.

*A 6 foot long iron rod bears S 80° E for 4.9 feet set by property owners.

Description of monument and accessories established to perpetuate the original location of this corner:

At the calculated corner position I set a 2" x 30" iron pipe with brass cap marked:


Set monument 15" in the ground with a mound of stones to within 6" of the cap from which:

A 16" Spruce bears S 9° E for 33.1 feet, scribed S-S 1/64 S27 BT.

A 13" White Fir bears S 68° W for 60.0 feet, scribed S-S 1/64 S28 BT.

Both BT's have a lower blaze scribed BT with a brass washer stamped PLS 1106 nailed flush. Attached signs 54-3 and painted a red ring around each BT.

Set a steel fence post on property line by monument and attached signs 54-2 and 54-9.

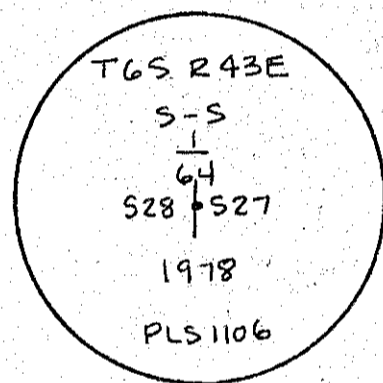

Witness: Les Wilson

Used magnetic compass with 20 1/2° E declination and measured to center of root crown on BT's with steel tape.

REGISTERED PROFESSIONAL LAND SURVEYOR

William R. Wells

OREGON JULY 22, 1977 WILLIAM R. WELLS 1106

11-1-78

Office of..... County of.....

State of..... I hereby certify that the within instrument was filed in this office for record on the..... day of....., 19.....

..... by (COUNTY OFFICER) (DEPUTY)

FILED Nov. 3, 1978 BAKER COUNTY SURVEYOR SURVEY NO. 6-43-32