


CERTIFIED RECORD OF LAND CORNER MONUMENTATION

History of original corner establishment:

No record of corner being established found in County Surveyors Office.

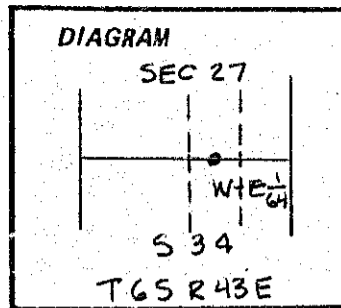

Description of corner evidence found: None.

A 4" x 4" white wood post bears N 3° W for 35.3 feet set by persons unknown.

Description of monument and accessories established to perpetuate the original location of this corner:

At the calculated corner position I set a 2" x 30" iron pipe with brass cap marked:


Set monument 22" in ground and surrounded with mound of stones to cap from which:

A 31" Ponderosa Pine bears N 25° E for 13.5 feet, scribed W-E 1/64 S27 BT.

A 10" Red Fir bears S 69 1/2° E for 16.9 feet, scribed W-E 1/64 S34 BT.

Both BT's have a lower blaze scribed BT with a brass washer stamped PLS 1106 nailed flush. Attached signs 54-3 and painted a red ring around each BT.

Set a steel fence post on property line by monument and attached signs 54-2 and 54-9.

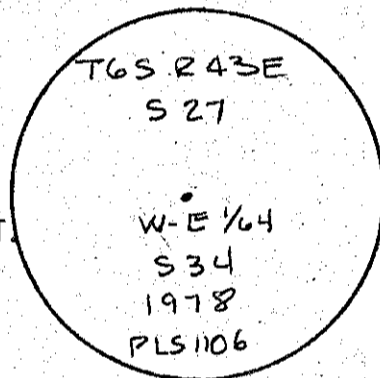

Witness: Les Wilson

Used magnetic compass with 20 1/2° E declination and measured to center of root crown on BT's with steel tape.

REGISTERED PROFESSIONAL LAND SURVEYOR

William R. Wells

OREGON JULY 22, 1977 WILLIAM R. WELLS 1106

11-1-78

Office of..... County of.....

State of..... I hereby certify that the within instrument was filed in this office for record on the..... day of....., 19.....

(COUNTY OFFICIAL)

(DEPUTY)

Form R6-7100-57 (9/71)

☆ GPO--798-276

FILED Nov 3 1978 BAKER COUNTY SURVEYOR SURVEY NO. 6-43-33