


CERTIFIED RECORD OF LAND CORNER MONUMENTATION

History of original corner establishment:

No record of corner being established found in County Surveyors Office.

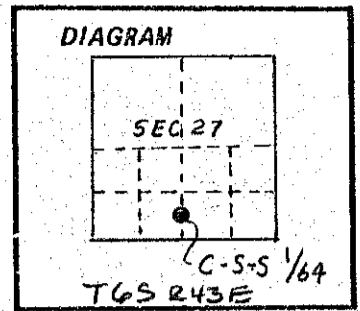


Description of corner evidence found:

None.

A white 4" x 4" wood post bears S 80° W for 50 feet ± set by persons unknown.

Description of monument and accessories I established to perpetuate the original location of this corner. At the corner position I set a 2" x 30" iron pipe with brass cap marked:

Set monument 20" in ground with a mound of stone from which:
A 20" Ponderosa Pine bears N 22° W for 35.1 feet, scribed C-S-S 1/64 S27 BT.
A 16" Ponderosa Pine bears N 11½° E for 21.2 feet, scribed C-S-S 1/64 S27 BT.
Both BT's have lower blaze scribed BT with a brass washer stamped PLS 1106 nailed flush. Attached signs 54-3 and painted a red ring around each BT.
Set a steel fence post on property line by monument and attached signs 54-2 and 54-9.

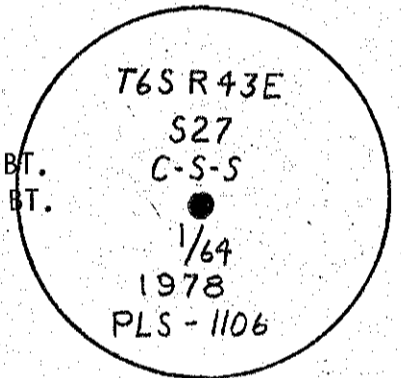

Witness: Les Wilson

Used magnetic compass with 20½° E declination and measured to center of root crown on BT's with steel tape.

REGISTERED
PROFESSIONAL
LAND SURVEYOR

William R. Wells

OREGON
JULY 22, 1977
WILLIAM R. WELLS
1106

11-1-78

Office of..... County of.....

State of..... I hereby certify that the within instrument was filed in this office
for record on the..... day of....., 19.....

..... by

(COUNTY OFFICIAL)

(DEPUTY)

Form R6-7100-57 (9/71)

☆ GPO--798.276

FILED Nov. 3, 1978
BAKER COUNTY SURVEYOR
SURVEY NO. 6-43-35