


CERTIFIED RECORD OF LAND CORNER MONUMENTATION

History of original corner establishment:

Corner established by RPE 2808 in OCTOBER 1972
(1/2" iron pin with plastic cap marked RPE 2808)

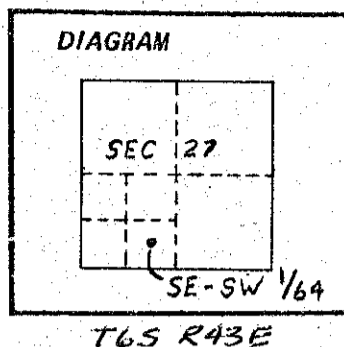


Description of corner evidence found:

1/2" iron pin with plastic cap marked RPE 2808.
The pin position bears $S39^{\circ}31' E$ for 1.56 feet from our calculated position.

Description of monument and accessories I established to perpetuate the original location of this corner. At the position of the 1/2" iron pin I set a 2" x 30" iron pipe with brass cap marked:

Set monument 18" in ground and surrounded with a mound of stone to within 6" of cap. Buried pin underground beside new monument. FROM WHICH:

A 26" White Fir bears N 20° E for 32.6 feet, scribed SE-SW 1/64 S27 BT.
A 16" Red Fir bears N 55° E for 46.6 feet, scribed SE-SW 1/64 S27 BT.
Both BT's have a lower blaze scribed BT with a brass washer stamped PLS 1106 nailed flush. Attached signs 54-3 and painted a red ring around each BT.
Set a steel fence post on property line by monument and attached signs 54-2 and 54-9.

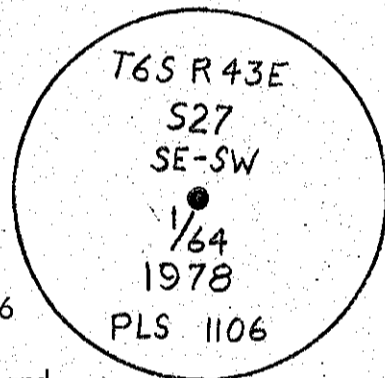

Witness: Les Wilson

Used magnetic compass with $20\frac{1}{2}^{\circ}$ E declination and measured to center of root crown on BT's with steel tape.

REGISTERED
PROFESSIONAL
LAND SURVEYOR

William R. Wells

OREGON
JULY 22, 1977
WILLIAM R. WELLS
1106

11-1-78

Office of..... County of.....

State of..... I hereby certify that the within instrument was filed in this office for record on the..... day of..... 19.....

..... by.....
(COUNTY OFFICIAL) (DEPUTY)