


CERTIFIED RECORD OF LAND CORNER MONUMENTATION

History of original corner establishment:

Corner established by RPE 2808 in *OCTOBER 1972*
(1/2" iron pin with plastic cap marked RPE 2808)

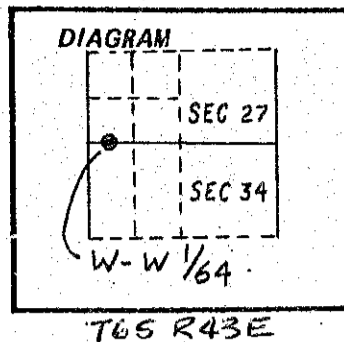


Description of corner evidence found:

1/2" iron pin with plastic cap marked RPE 2808.
The pin position bears *N53°35'W* for 1.55 feet from our calculated position.

Description of monument and accessories I established to perpetuate the

original location of this corner: At the position of the 1/2" iron pin I set a
2" x 30" iron pipe with brass cap marked:
Set monument 24" in ground and leveled a 3 foot flat spot around
monument. Buried pin underground next to monument.

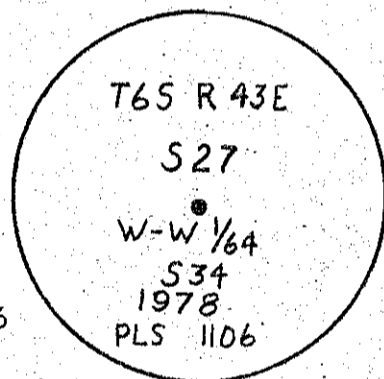

A 15 1/2" Spruce bears S 22 1/2° E for 12.0 feet, scribed W-W 1/64 S34 BT.
A 17" White Fir bears N 11 1/2° W for 19.7 feet, scribed W-W 1/64 S27 BT.
Both BT's have a lower blaze scribed BT with a brass washer stamped PLS 1106
nailed flush. Attached signs 54-3 and painted a red ring around each BT.
Set a steel fence post on property line by monument and attached signs 54-2 and
54-9.

Witness: Les Wilson

Used magnetic compass with 20 1/2° E declination and measured to center of root crown on BT's with
steel tape.

REGISTERED
PROFESSIONAL
LAND SURVEYOR

William R. Wells

OREGON
JULY 22, 1977
WILLIAM R. WELLS
1106

11-1-78

Office of..... County of.....

State of..... I hereby certify that the within instrument was filed in this office
for record on the..... day of....., 19.....

..... by.....
(COUNTY OFFICIAL) (DEPUTY)