


CERTIFIED RECORD OF LAND CORNER MONUMENTATION

History of original corner establishment:

Corner position established by RPE 2808 in OCTOBER 1972  
(1/2" iron pin with plastic cap marked RPE 2808)

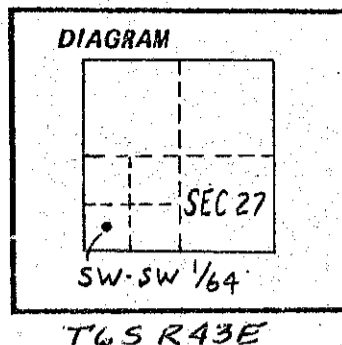

Description of corner evidence found:

\*Note: A 1/2" iron pin with plastic cap stamped RPE 2808 bears N 57° 19' W - 22.94 FT from our calculated position.

Description of monument and accessories I established to perpetuate the original location of this corner. At our calculated corner position I set a 2" x 30" iron pipe with brass cap marked:


Set monument 24" in ground and surrounded with a mound of stone from which:

A 13 1/2" Spruce bears S 13 1/2° W for 57.2 feet, scribed SW-SW 1/64 S27 BT.

A 10 1/2" Red Fir bears S 24° W for 60.3 feet, scribed SW-SW 1/64 S27 BT.

Both BT's have a lower blaze scribed BT with a brass washer stamped PLS 1106 nailed flush. Attached signs 54-3 and painted a red ring around each BT.

Set a steel fence post on property line by monument and attached signs 54-2 and 54-9.

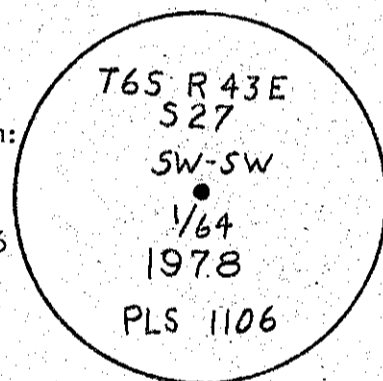

Witness: Les Wilson

Used magnetic compass with 20 1/2° E declination and measured to center of root crown on BT's with steel tape.

REGISTERED  
PROFESSIONAL  
LAND SURVEYOR

William R. Wells

OREGON  
JULY 22, 1977  
WILLIAM R. WELLS  
1106

11-1-78

Office of..... County of.....

State of..... I hereby certify that the within instrument was filed in this office for record on the..... day of....., 19.....

..... by..... (COUNTY OFFICIAL) (DEPUTY)