


CERTIFIED RECORD OF LAND CORNER MONUMENTATION

History of original corner establishment:

No record of corner being established found in County Surveyors Office.

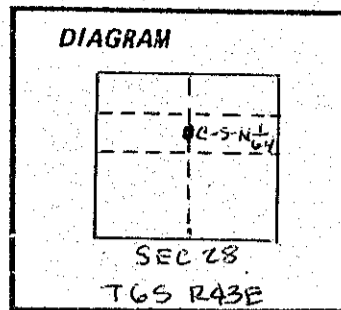

Description of corner evidence found:

None.

Description of monument and accessories I established to perpetuate the original location of this corner:

At the calculated corner position I set a 2" x 30" iron pipe with brass cap marked:


Set monument 20" in ground and surrounded with mound of stones from which:

A 7 1/2" Red Fir bears N 47° E for 3.4 feet, scribed C-S-N 1/64 S28 BT.

An 8" Red Fir bears N 59° W for 24.3 feet, scribed C-S-N 1/64 S28 BT.

BT's have a lower blaze scribed BT with a brass washer stamped PLS 1106 nailed flush. Attached signs 54-3 and painted a red ring around BT's.

Set a steel fence post on property line by monument and attached signs 54-2 and 54-9.

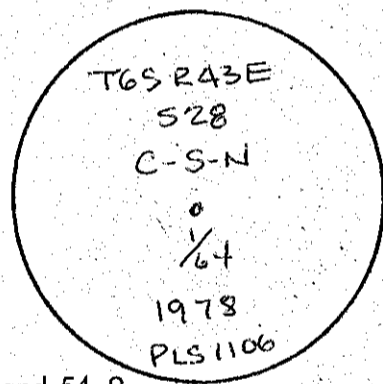

Witness: Les Wilson
Greg Flowers

Used magnetic compass with 19 1/2° E declination and measured to center of root crown on BT's with steel tape.

REGISTERED
PROFESSIONAL
LAND SURVEYOR

William R. Wells

OREGON
JULY 22, 1977
WILLIAM R. WELLS
1106

11-1-78

Office of..... County of.....

State of..... I hereby certify that the within instrument was filed in this office

for record on the..... day of....., 19.....

..... by.....

(COUNTY OFFICIAL)

(DEPUTY)

Form R6-7100-57 (9/71)

GPO-798-276

FILED Nov. 3, 1978

BAKER COUNTY SURVEYOR

SURVEY NO. 6-43-41