


CERTIFIED RECORD OF LAND CORNER MONUMENTATION

History of original corner establishment:


No record of corner being established found in County Surveyors Office.

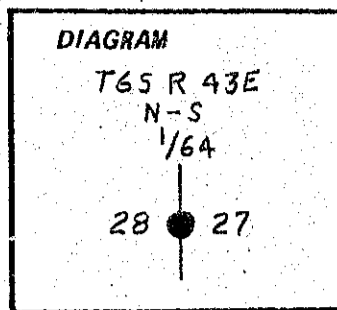

Description of corner evidence found:

None.

Description of monument and accessories I established to perpetuate the original location of this corner: At the corner position I set a 2" x 30" iron pipe with brass cap marked:
 Set monument 15" in ground to solid rock and surrounded with a mound of stone to within 6" of cap from which:
 A 25" Ponderosa Pine bears N 33° W for 98.3 feet, scribed N-S 1/64 S28 BT.
 A 27 1/2" Ponderosa Pine bears S 47 1/2° E for 116.7 feet, scribed N-S 1/64 S27 BT.
 Both BT's have a lower blaze scribed BT with a brass washer stamped PLS 1106 nailed flush. Attached signs 54-3 and painted a red ring around each BT.
 Set a steel fence post on property line by monument and attached signs 54-2 and 54-9.

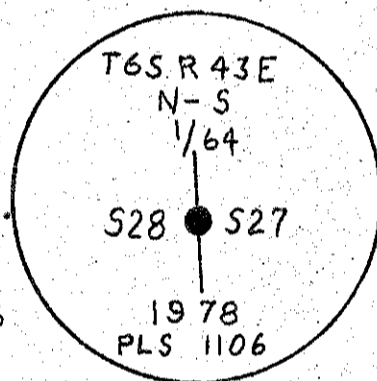

Witness: Les Wilson

Used magnetic compass with 20 1/2° E declination and measured to center of root crown on BT's with steel tape.

REGISTERED
 PROFESSIONAL
 LAND SURVEYOR

William R. Wells

OREGON
 JULY 22, 1977
 WILLIAM R. WELLS
 1106

11-1-78

Office of..... County of.....

State of..... I hereby certify that the within instrument was filed in this office for record on the..... day of....., 19.....

..... by (COUNTY OFFICIAL) (DEPUTY)

FILED *Nov. 3, 1978*
 BAKER COUNTY SURVEYOR
 SURVEY NO. *6-43-42*