


CERTIFIED RECORD OF LAND CORNER MONUMENTATION

History of original corner establishment:

No record of corner being established found in County Surveyors Office.

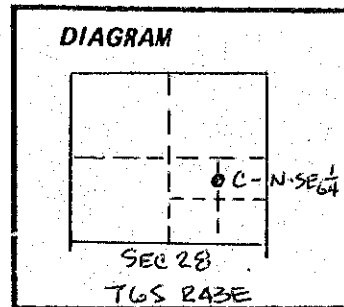

Description of corner evidence found:

None.

Description of monument and accessories established to perpetuate the original location of this corner:

At the calculated corner position I set a 2" x 30" iron pipe with brass cap marked:


Set monument 7" below road surface from which:

A 23" Bull Pine bears N 69 1/2° E for 94.8 feet, scribed C-N-SE 1/64 S28 BT. A 30" Red Fir bears N 27 1/2° E for 92.2 feet, scribed C-N-SE 1/64 S28 BT. Both BT's have a lower blaze scribed BT with a brass washer stamped PLS 1106 nailed flush. Attached signs 54-3 and painted a red ring around each BT.

Set a wood fence post on property line by monument and attached signs 54-2, 54-9 and 54-5.

Witness: Les Wilson
Greg Flowers

Used magnetic compass with 19 1/2° E declination and measured to center of root crown on BT's with steel tape.

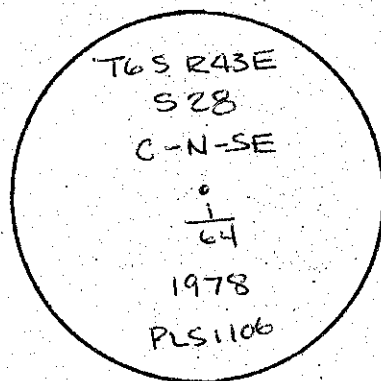

REGISTERED
PROFESSIONAL
LAND SURVEYOR

William R. Wells

OREGON
JULY 22, 1977
WILLIAM R. WELLS
1106

11-1-78

Office of..... County of.....

State of..... I hereby certify that the within instrument was filed in this office for record on the..... day of....., 19.....

..... by
(COUNTY OFFICER) (DEPUTY)

FILED Nov. 3, 1978
BAKER COUNTY SURVEYOR
SURVEY NO. 6-43-44