


CERTIFIED RECORD OF LAND CORNER MONUMENTATION

History of original corner establishment:

No record of corner being established found in County Surveyors Office.

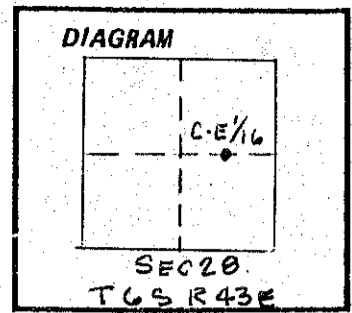

Description of corner evidence found:

None.

Description of monument and accessories I established to perpetuate the original location of this corner.

At the calculated corner position I set a 2" x 30" iron pipe with brass cap marked:


Set monument 20" in ground with mound of stone from which:

An 11" Red Fir bears N 45 1/4° W for 9.3 feet, scribed C-E 1/16 S28 BT.

A 9" Bull Pine bears S 73-3/4° E for 46.6 feet, scribed C-E 1/16 S28 BT.

BT's have a lower blaze scribed BT with a brass washer stamped PLS 1106 nailed flush. Attached signs 54-3 and painted a red ring around BT's.

Set steel fence post on property line near monument and attached signs 54-2 and 54-9.

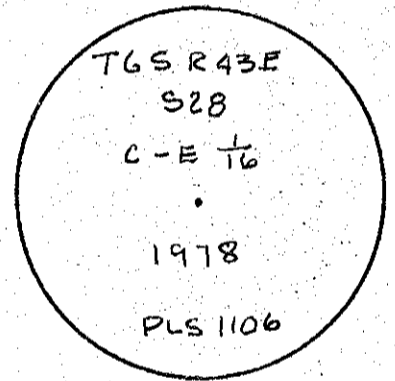

Witness: Les Wilson
Greg Flowers

Used magnetic compass with 19 1/2° E declination and measured to center of root crown on BT's with steel tape.

REGISTERED
PROFESSIONAL
LAND SURVEYOR

William R. Wells

OREGON
JULY 22, 1977
WILLIAM R. WELLS
1106

11-1-78

Office of..... County of.....
State of..... I hereby certify that the within instrument was filed in this office
for record on the..... day of....., 19.....

(COUNTY OFFICIAL)

(DEPUTY)

FILED Nov. 3, 1978
BAKER COUNTY SURVEYOR
SURVEY NO. 6-43-46