


CERTIFIED RECORD OF LAND CORNER MONUMENTATION

History of original corner establishment:

No record of corner being established found in County Surveyors Office.

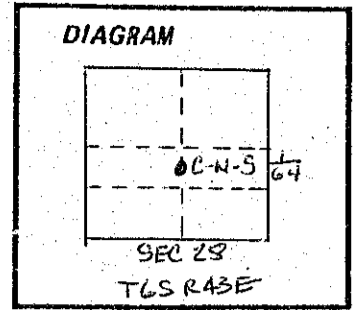

Description of corner evidence found:

None.


Description of monument and accessories I established to perpetuate the original location of this corner:

At the calculated corner position I set a 2" x 30" iron pipe with brass cap marked:

Set monument 24" in ground with mound of stones to cap from which:

A 16" Spruce bears N 80 1/2° W for 24.5 feet, scribed C-N-S 1/64 S28 BT.
A 23" Red Fir bears S 27-3/4° E for 25.8 feet, scribed C-N-S 1/64 S28 BT.
Both BT's have a lower blaze scribed BT with a brass washer stamped PLS 1106 nailed flush. Attached signs 54-3 and painted a red ring around each BT.

Set a steel fence post on property line by monument and attached signs 54-2 and 54-9.

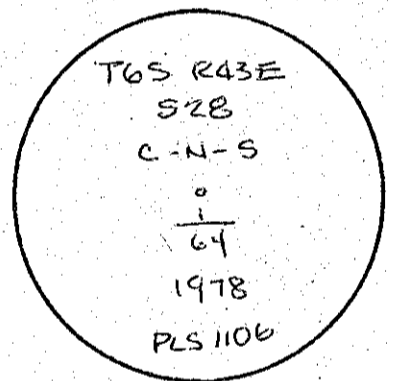

Witness: Les Wilson
Greg Flowers

Used magnetic compass with 19 1/2° E declination and measured to center of root crown on BT's with steel tape.

REGISTERED
PROFESSIONAL
LAND SURVEYOR

William R. Wells

OREGON
JULY 22, 1977
WILLIAM R. WELLS
1106

11-1-78

Office of..... County of.....

State of..... I hereby certify that the within instrument was filed in this office for record on the..... day of....., 19.....

..... by
(COUNTY OFFICIAL) (DEPUTY)

Form R6-7100-57 (9/71)

☆ GPO - 798-276

FILED Nov. 3, 1978
BAKER COUNTY SURVEYOR
SURVEY NO. 6-43-47