


CERTIFIED RECORD OF LAND CORNER MONUMENTATION

History of original corner establishment:

No record of corner being established found in County Surveyors Office.

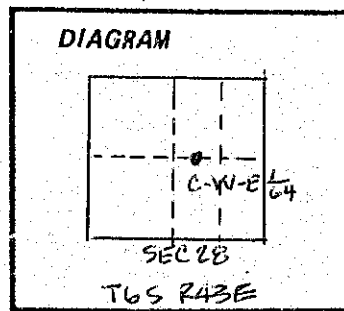

Description of corner evidence found:

None.

Description of monument and accessories I established to perpetuate the original location of this corner:


At the calculated corner position I set a 2" x 30" iron pipe with brass cap marked:

Set monument 24" in ground with mound of stones from which:

A 27 1/2" Ponderosa Pine bears N 25-3/4° E for 88.0 feet, scribed C-W-E 1/64 S28 BT. A 14 1/2" Red Fir bears N 73-3/4° E for 57.8 feet, scribed C-W-E 1/64 S28 BT.

BT's have a lower blaze scribed BT with a brass washer stamped PLS 1106 nailed flush. Attached signs 54-3 and painted a red ring around BT's.

Set a wood fence post on property line by monument and attached signs 54-2, 54-9 and 54-5.

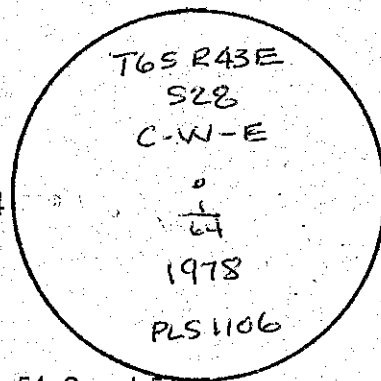

Witness: Les Wilson  
Greg Flowers

Used magnetic compass with 19 1/2° E declination and measured to center of root crown on BT's with steel tape.

REGISTERED  
PROFESSIONAL  
LAND SURVEYOR

*William R. Wells*

OREGON  
JULY 22, 1977  
WILLIAM R. WELLS  
1106

11-1-78

Office of..... County of.....

State of..... I hereby certify that the within instrument was filed in this office for record on the..... day of....., 19.....

..... by .....  
(COUNTY OFFIC:AI) (DEPUTY)

FILED Nov. 3, 1978  
BAKER COUNTY SURVEYOR  
SURVEY NO. 6-43-49