


CERTIFIED RECORD OF LAND CORNER MONUMENTATION

History of original corner establishment:

No record of corner being established found in County Surveyors Office.

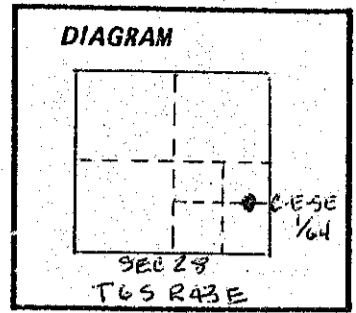

Description of corner evidence found:

None.

Description of monument and accessories I established to perpetuate the original location of this corner:

At the calculated corner position I set a 2" x 30" iron pipe with brass cap marked:


Set monument 20" in ground and surrounded with stones to within 2" of cap from which:

A 12" Pine bears S 6 1/2° W for 24.8 feet, scribed C-E-SE 1/64 S28 BT.

A 14" Spruce bears S 79° W for 53.0 feet, scribed C-E-SE 1/64 S28 BT.

BT's have a lower blaze scribed BT with a brass washer stamped PLS 1106 nailed flush. Attached signs 54-3 and painted a red ring around BT's.

Set steel fence post on property line near monument and attached signs 54-2 and 54-9.

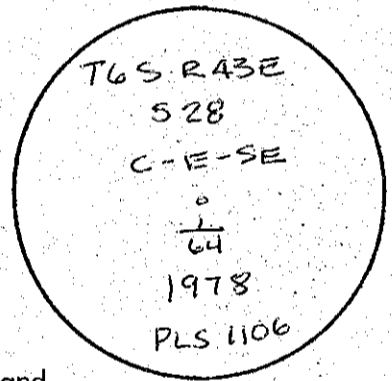

Witness: Les Wilson  
Gene Salter

Used Magnetic compass with 19 1/2° E declination and measured to center of root crown on BT's with steel tape.

REGISTERED  
PROFESSIONAL  
LAND SURVEYOR

*William R. Wells*

OREGON  
JULY 22, 1977  
WILLIAM R. WELLS  
1106

11-1-78

Office of..... County of.....

State of..... I hereby certify that the within instrument was filed in this office

for record on the..... day of....., 19.....

..... by.....

(COUNTY OFFICIAL)

(DEPUTY)

FILED Nov. 3, 1978  
BAKER COUNTY SURVEYOR  
SURVEY NO. 6-43-51