


CERTIFIED RECORD OF LAND CORNER MONUMENTATION

History of original corner establishment:

No record of corner being established found in County Surveyors Office.

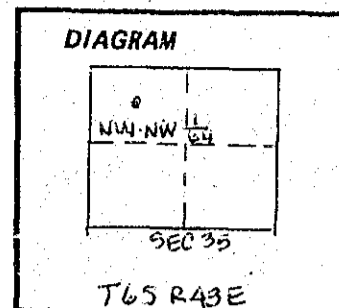

Description of corner evidence found:


None.

Description of monument and accessories I established to perpetuate the original location of this corner:

At the calculated corner position I set a 2" x 30" iron pipe with brass cap marked:

Set monument 28" in ground and leveled flat spot around it from which:  
A 17" Ponderosa Pine bears N 15 $\frac{1}{2}$ ° E for 21.2 feet, scribed NW-NW 1/64 S35 BT. A 25 $\frac{1}{2}$ " Ponderosa Pine bears S 48° E for 63.0 feet, scribed NW-NW 1/64 S35 BT.

BT's have a lower blaze scribed BT with a brass washer stamped PLS 1106 nailed flush. Attached signs 54-3 and painted a red ring around BT's. Set steel fence post on property line near monument and attached signs 54-2 and 54-9.

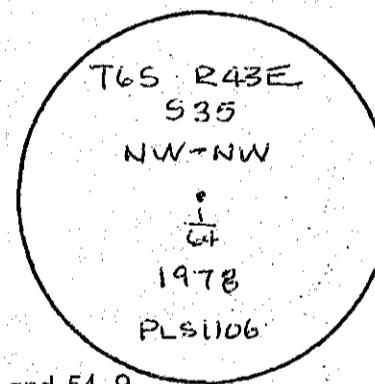

Witness: Les Wilson  
Gene Salter

Used magnetic compass with 19 $\frac{1}{2}$ ° E declination and measured to center of root crown on BT's with steel tape.

REGISTERED  
PROFESSIONAL  
LAND SURVEYOR

*William R. Wells*

OREGON  
JULY 22, 1977  
WILLIAM R. WELLS  
1106

11-1-78

Office of..... County of.....  
State of....., I hereby certify that the within instrument was filed in this office  
for record on the..... day of....., 19.....

(COUNTY OFFICIAL)

(DEPUTY)

Form R6-7100-57 (9/71)

(GPC-798-276)

FILED *Nov. 3, 1978*  
BAKER COUNTY SURVEYOR  
SURVEY NO. *6-43-55*