


CERTIFIED RECORD OF LAND CORNER MONUMENTATION

History of original corner establishment:

No record of corner being established found in County Surveyors Office.

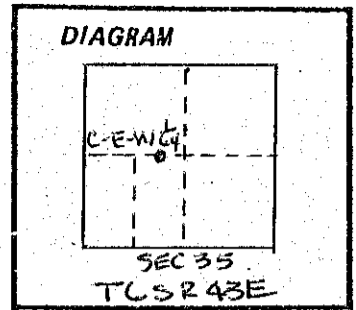

Description of corner evidence found:

None.

Description of monument and accessories I established to perpetuate the original location of this corner: *THE CALCULATED CORNER FALLS IN EAGLE CREEK. SET 2"X30" IRON PIPE WITH BRASS CAP FOR A WITNESS CORNER. CAP IS MARKED 12.00 FT. THE WITNESS CORNER BEARS S 10° 06' 51" E FROM TRUE CORNER POSITION*

Set monument 10" in ground and surrounded with mound of stones to within 5" of cap from which:

A 19" Red Fir bears S 8° E for 25.1 feet, scribed X BT.


A 17½" Tamarack bears N 10° E for 85.0 feet, scribed X BT.

Both BT's have a lower blaze scribed BT with a brass washer stamped PLS 1106 nailed flush. Attached signs 54-3 and painted a red ring around each BT.

Set a steel fence post on property line by monument and attached signs 54-2 and 54-9.

Witness: Les Wilson
Gene Salter

Used magnetic compass with 19½° E declination and measured to center of root crown on BT's with steel tape.

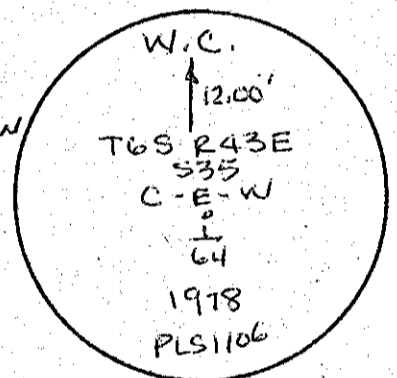

REGISTERED
PROFESSIONAL
LAND SURVEYOR

William R. Wells

OREGON
JULY 22, 1977
WILLIAM R. WELLS
1106

11-1-78

Office of..... County of.....

State of..... I hereby certify that the within instrument was filed in this office

for record on the..... day of....., 19.....

..... by.....
(COUNTY OFFICIAL) (DEPUTY)

Form R6-7100-57 (9/71)

☆ GPO - 798-276

FILED Nov 3 1978

BAKER COUNTY SURVEYOR
SURVEY NO. 6-43-57