


CERTIFIED RECORD OF LAND CORNER MONUMENTATION

History of original corner establishment:

No record of corner being established found in County Surveyors Office.

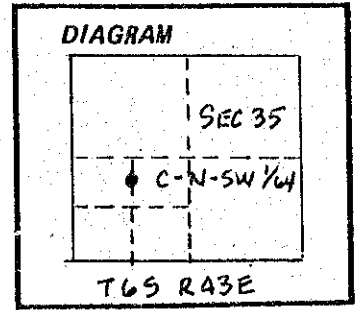

Description of corner evidence found: None.

Description of monument and accessories I established to perpetuate the original location of this corner.

At the calculated corner position I set a 2" x 30" iron pipe with brass cap marked:


Set monument 24" in ground and surrounded with mound of stones to cap from which:

An 11" Red Fir bears S 56 1/2° W for 8.6 feet, scribed C-N-SW 1/64 S35 BT.

A 10" Red Fir bears N 12 1/2° E for 23.0 feet, scribed C-N-SW 1/64 S35 BT.

Both BT's have a lower blaze scribed BT with a brass washer stamped PLS 1106 nailed flush. Attached signs 54-3 and painted a red ring around each BT.

Set a steel fence post on property line by monument and attached signs 54-2 and 54-9.

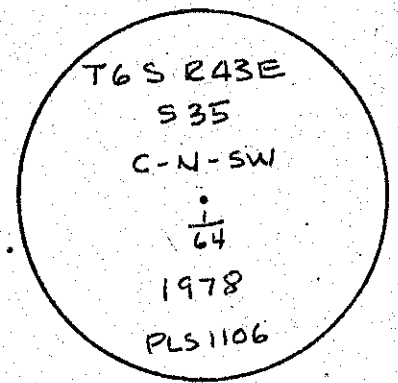

Witness: Les Wilson

Used magnetic compass with 19 1/2° E declination and measured to center of root crown on BT's with steel tape.

REGISTERED PROFESSIONAL LAND SURVEYOR

William R. Wells

OREGON JULY 22, 1977 WILLIAM R. WELLS 1106

11-1-78

Office of..... County of.....

State of..... I hereby certify that the within instrument was filed in this office for record on the..... day of....., 19.....

..... by (COUNTY OFFICIAL) (DEPUTY)

FILED Nov. 3, 1978 BAKER COUNTY SURVEYOR SURVEY NO. 6-43-58