


CERTIFIED RECORD OF LAND CORNER MONUMENTATION

History of original corner establishment:

No record of corner being established found in County Surveyors Office.

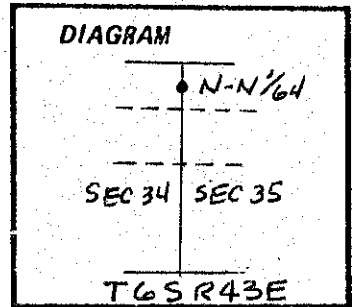

Description of corner evidence found: None.

Description of monument and accessories I established to perpetuate the original location of this corner.

At the calculated corner position I set a 2" x 30" iron pipe with brass cap marked:

Set monument 26" in ground with mound of stone to cap from which:


A 10" Ponderosa Pine bears N 26 1/2° W for 35.5 feet, scribed N-N 1/64 S34 BT.

A 21" Ponderosa Pine bears N 64° E for 14.5 feet, scribed N-N 1/64 S35 BT.

Both BT's have a lower blaze scribed BT with a brass washer stamped

PLS 1106 nailed flush. Attached signs 54-3 and painted a red ring around each BT.

Set a steel fence post on property line by monument and attached signs 54-2 and 54-9.

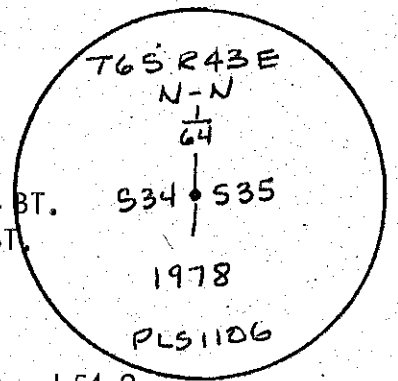

Witness: Les Wilson

Used magnetic compass with 19 1/2° E declination and measured to center of root crown on BT's with steel tape.

REGISTERED PROFESSIONAL LAND SURVEYOR

William R. Wells

OREGON JULY 22, 1977 WILLIAM R. WELLS 1106

11-1-78

Office of..... County of.....

State of..... I hereby certify that the within instrument was filed in this office for record on the..... day of....., 19.....

..... by (COUNTY OFFICIAL) (DEPUTY)

Form R6-7100-57 (9/71)

ITGPO-798-276

FILED Nov. 3, 1978

BAKER COUNTY SURVEYOR SURVEY NO. 6-43-59