


CERTIFIED RECORD OF LAND CORNER MONUMENTATION

History of original corner establishment:

No record of corner being established found in County Surveyors Office.

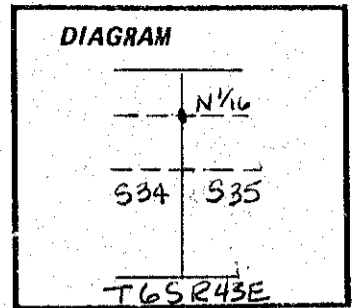

Description of corner evidence found: None.

Description of monument and accessories I established to perpetuate the original location of this corner.

At the calculated corner position I set a 2" x 30" iron pipe with brass cap marked:


Set monument 6" below road surface from which:

A 13" Ponderosa Pine bears N 66½° W for 138.7 feet, scribed N 1/16 S34 BT.

A 16" Red Fir bears S 20° E for 61.1 feet, scribed N 1/16 S35 BT.

Both BT's have a lower blaze scribed BT with a brass washer stamped PLS 1106 nailed flush. Attached signs 54-3 and painted a red ring around each BT.

Set a steel fence post on section line by monument and attached sign 54-9.

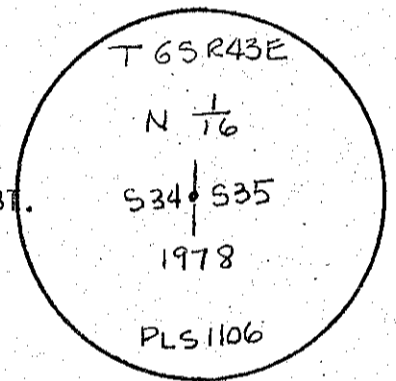

Witness: Les Wilson

Used magnetic compass with 19½° E declination and measured to center of root crown on BT's with steel tape.

REGISTERED  
PROFESSIONAL  
LAND SURVEYOR

*William R. Wells*

OREGON  
JULY 22, 1977  
WILLIAM R. WELLS  
1106

11-1-78

Office of..... County of.....

State of..... I hereby certify that the within instrument was filed in this office

for record on the..... day of....., 19.....

..... by .....

(COUNTY OFFICIAL)

(DEPUTY)

Form R6-7100-57 (9/71)

GPO-798-276

FILED Nov. 3, 1978  
BAKER COUNTY SURVEYOR  
SURVEY NO. 6-43-60