


CERTIFIED RECORD OF LAND CORNER MONUMENTATION

History of original corner establishment:

No record of corner being established found in County Surveyors Office.

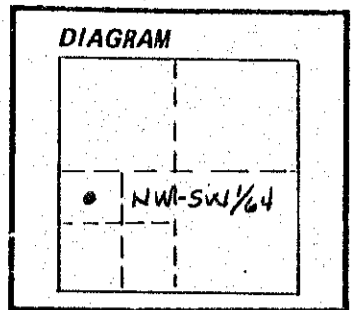

SEC 35  
T 6 S R 43 E

Description of corner evidence found: None.

Description of monument and accessories I established to perpetuate the original location of this corner:

At the calculated corner position I set a 2" x 30" iron pipe with brass cap marked:


Set monument 20" in ground and leveled flat spot on hillside and mounded earth to within 6" of cap from which:

A 19" White Fir bears S 58 1/2° W for 12.0 feet, scribed NW-SW 1/64 S35 BT.

A 21" White Fir bears N 55 1/2° W for 50.9 feet, scribed NW-SW 1/64 S35 BT.

Both BT's have a lower blaze scribed BT with a brass washer stamped PLS 1106 nailed flush. Attached signs 54-3 and painted a red ring around each BT.

Set a steel fence post on property line by monument and attached signs 54-2 and 54-9.

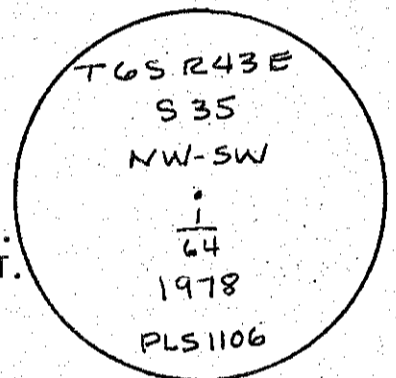

Witness: Les Wilson

Used magnetic compass with 19 1/2° E declination and measured to center of root crown on BT's with steel tape.

REGISTERED  
PROFESSIONAL  
LAND SURVEYOR

*William R. Wells*

OREGON  
JULY 22, 1977  
WILLIAM R. WELLS  
1106

11-1-78

Office of..... County of.....  
State of..... I hereby certify that the within instrument was filed in this office  
for record on the..... day of....., 19.....

..... by .....  
(COUNTY OFFICER) (DEPUTY)

Form R6-7100-57 (9/71)

☆ GPO --- 798-276

FILED Nov. 3, 1978  
BAKER COUNTY SURVEYOR  
SURVEY NO. 6-43-61