


CERTIFIED RECORD OF LAND CORNER MONUMENTATION

History of original corner establishment:

No record of corner being established found in County Surveyors Office.

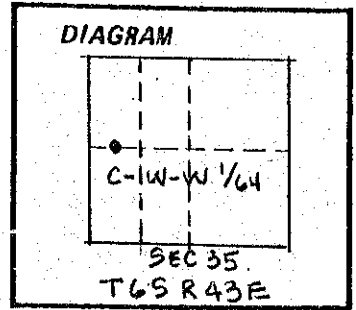

Description of corner evidence found:


None.

Description of monument and accessories I established to perpetuate the original location of this corner:

At the calculated corner position I set a 2" x 30" iron pipe with brass cap marked:

Set monument 24" in ground and leveled flat spot from which:
 A 9" Tamarack bears S 22 1/2° W for 33.2 feet, scribed C-W-W 1/64 S35 BT.
 A 19" Red Fir bears N 67° W for 38.7 feet, scribed C-W-W 1/64 S35 BT.
 Both BT's have a lower blaze scribed BT with a brass washer stamped
 PLS 1106 nailed flush. Attached signs 54-3 and painted a red ring
 around each BT.

Set a steel fence post on property line by monument and attached signs 54-2 and 54-9.

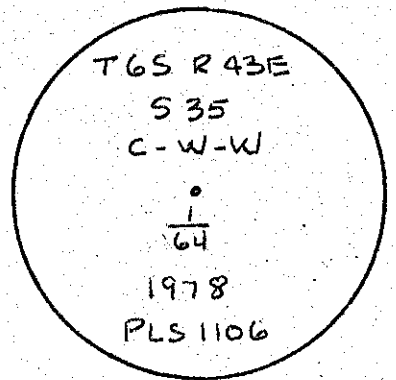

Witness: Les Wilson

Used magnetic compass with 19 1/2° E declination and measured to center of root crown on BT's with steel tape.

REGISTERED
 PROFESSIONAL
 LAND SURVEYOR

William R. Wells

OREGON
 JULY 22, 1977
 WILLIAM R. WELLS
 1106

11-1-78

Office of..... County of.....

State of....., I hereby certify that the within instrument was filed in this office for record on the..... day of....., 19.....

..... by
(COUNTY OFFICIAL) (DEPUTY)

Form R6-7100-57 (9/71)

GPO--798-276

FILED *Nov. 3, 1978*
 BAKER COUNTY SURVEYOR
 SURVEY NO. *6-43-62*