


CERTIFIED RECORD OF LAND CORNER MONUMENTATION

History of original corner establishment:

No record of corner being established found in County Surveyors Office.

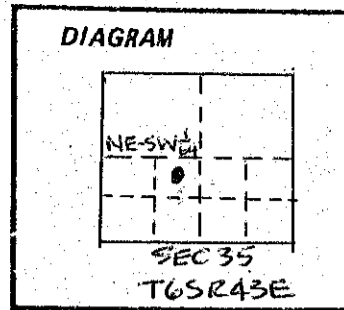

Description of corner evidence found:

None.

Description of monument and accessories I established to perpetuate the original location of this corner:

At the calculated corner position I set a 2" x 30" iron pipe with brass cap marked:


Set monument 8" in ground and surrounded with mound of stone to within 1" of cap from which:

A 10 1/2" Red Fir bears N 83° E for 35.2 feet, scribed NE-SW 1/64 S35 BT.

A 9" Red Fir bears N 5 1/2° W for 32.0 feet, scribed NE-SW 1/64 S35 BT.

Both BT's have a lower blaze scribed BT with a brass washer stamped PLS 1106 nailed flush. Attached signs 54-3 and painted a red ring around each BT.

Set a steel fence post on property line by monument and attached signs 54-2 and 54-9.

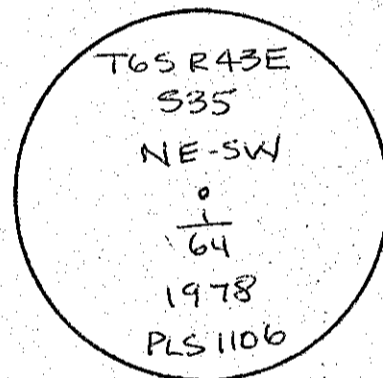

Witness: Les Wilson
Gene Salter

Used magnetic compass with 19 1/2° E declination and measured to center of root crown on BT's with steel tape.

REGISTERED
PROFESSIONAL
LAND SURVEYOR

William R. Wells

OREGON
JULY 22, 1977
WILLIAM R. WELLS
1106

11-1-78

Office of..... County of.....

State of..... I hereby certify that the within instrument was filed in this office for record on the..... day of....., 19.....

..... by.....

(COUNTY OFFICIAL)

(DEPUTY)

Form R6-7100-57 (9/71)

☆ GPD--798-276

FILED Nov 3 1978
BAKER COUNTY SURVEYOR
SURVEY NO. 6-43-66