


CERTIFIED RECORD OF LAND CORNER MONUMENTATION

History of original corner establishment:

Corner established by W. B. Barr under G L O contract No. 503, dated May 23, 1884.

Surveyor's General records state:

Set a granite rock 15 x 8 x 6 ins, 10 inches in the ground for corner to secs 25, 26, 35, and 36 marked with 1 notch on the S and W edges from which;

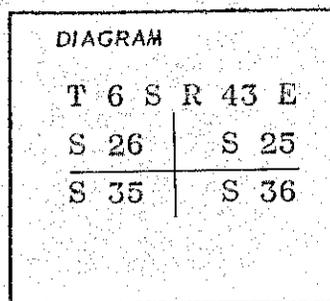

- A fir 9 ins diam bears N 85° E, 57 lks dist marked T 6 S R 43 E S 25 BT.
- A pine 30 ins diam bears N 7½° W, 14 lks dist marked T 6 S R 43 E S 26 BT.
- A pine 10 ins diam bears S 40° W, 114 lks dist marked T 6 S R 43 E S 35 BT.
- A fir 12 ins diam bears S 80½° E, 225 lks dist marked T 6 S R 43 E S 36 BT.

Description of corner evidence found:

- A fir 36 ins diam with healed blaze with blue paint for section 25 BT.
- A pine 30 ins diam with healed blaze for section 35 BT.
- A pine 48 ins with visible scribe marks on a partially healed blaze for section 26 BT.
- A basalt stone 15 x 6 x 4 ins, 12 ins in the ground with 1 notch on the E face at a point S 85° W, 57 lks dist from section 25 BT. This stone is N 40° E, 14 lks dist from section 35 BT and S 7½° E, 114 lks dist from section 26 BT which indicates the distances in the original field notes were mixed up for these two bearing trees.

Description of monument and accessories established to perpetuate the original location of this corner

At the location of the original stone set a 2½ inch brass cap on a 1 inch iron pipe, 31 inches long, 26 inches in the ground and buried the stone alongside.



Brass cap marked thus:

T 6	S R	43	E
S 26			S 25
S 35			S 36

CS 1978

New beating tree:

A pine 11 ins diam bears S 29° E, 18.0 ft dist marked T 6 S R 43 E S 36 BT

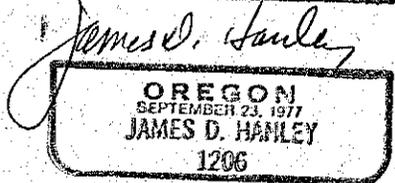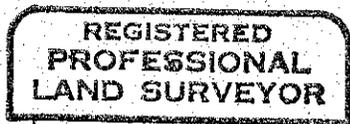

I hereby certify the above corner monument was re-established as herein described and witnessed by Brad Gordon (instrumentman) and Tom Fisk (chainman).

Office of County Surveyor County of Baker
 State of Oregon, I hereby certify that the within instrument was filed in this office for record on the _____ day of _____
 _____ by _____
 (COUNTY OFFICIAL) (DEPUTY)

FILED Dec. 8, 1978
 BAKER COUNTY SURVEYOR
 SURVEY NO. 6-43-67