

CERTIFIED RECORD OF LAND CORNER MONUMENTATION

V-23


History of original corner establishment:

Corner established by W. B. Barr under GLO contract no. 503 dated May 23, 1884.

Surveyor General records state:

Set sandstone 20x12x10 ins 15 ins in ground for 1/4 sec cor marked 1/4 on the N side from which;

A pine 30 ins diam bears S 5° E, 125 lks dist marked 1/4SBT
A pine 20 ins diam bears N 50° W, 200 lks dist marked 1/4SBT

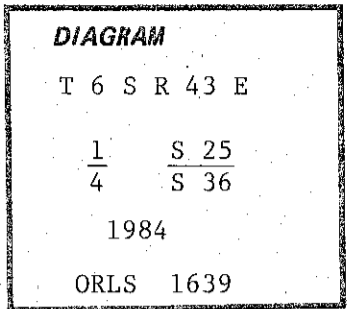

Description of corner evidence found:

None. Corner position established by survey methods described on accompanying official RECORD OF SURVEY PLAT for dependent resurvey of a portion of T 6 S, R 44 E, WM.

Description of monument and accessories established to perpetuate the original location of this corner:

Set 2 1/2" aluminum cap on 2" aluminum pipe 31" long buried 27" in ground with 4" proj. from ground with surrounding rock mound and 6' steel fence post alongside with sign 54-9 attached.

Aluminum cap marked as shown in corner diagram.
New bearing trees:
A fir 8 ins dia bears N34° W, 41.2 ft marked 1/4S25 BT.
A fir 8 ins dia bears S15° W, 48.6 ft marked 1/4S36 BT.

Each new bearing tree has a brass washer marked PLS 1639 nailed flush with BT blaze and has signs 54-3 and 54-9 attached below a 6 inch band of red paint.

I hereby certify that the above described corner monument was properly established by me on Nov. 13, 1984 and witnessed by Jim DeMastus and Daryl Schuchardt.

Jim DeMastus

REGISTERED
PROFESSIONAL
LAND SURVEYOR

William L Hanley

OREGON
JULY 14, 1978
WILLIAM L. HANLEY
1639

Office of.....County Surveyor..... County of... Baker.....
State of..... Oregon....., I hereby certify that the within instrument was filed in this office
for record on the..... day of....., 19.....

..... by
(COUNTY OFFICIAL) (DEPUTY)

FILED 4-28-86
BAKER COUNTY SURVEYOR
SURVEY NO. 6-43-71