

CERTIFIED RECORD OF LAND CORNER MONUMENTATION

X-21

History of original corner establishment:


Corner established by W. B. Barr under G L O contract No. 503, dated May 23, 1884.

Surveyor's General records state:

Set sandstone 15x12x8 ins 10 ins in ground for 1/4 sec cor marked 1/4 on the W side from which:

A pine 38 ins diam bears S 25° E, 30 lks dist marked 1/4SBT

A pine 24 ins diam bears S 45° E, 37 lks dist marked 1/4SBT

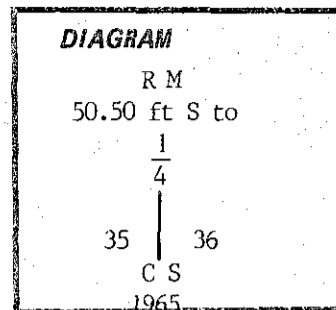

Corner REESTABLISHED by James D. Hanley in September, 1965.....

Set 1" galvanized pipe with 2" aluminum cap marked as shown in corner diagram, 50.50 ft north of true corner location as reference monument.

Description of corner evidence found:

Original corner position destroyed by road construction.

Found aluminum cap monument as described above with small rock mound.

Description of monument and accessories established to perpetuate the original location of this corner:

Improved surrounding rock mound around corner monument and set a 6 foot steel fence post alongside with sign 54-9 attached.

New bearing trees established:

A ponderosa pine 12 ins dia bears N64°E, 44.0 ft marked 1/4S36 BT.

A ponderosa pine 15 ins dia bears N81°W, 39.8 ft marked 1/4S35 BT.

Each new bearing tree has a brass washer marked PLS 1639 nailed flush with BT blaze and has signs 54-3 and 54-9 attached below a 6 inch band of red paint.

I hereby certify that the above corner monument was properly maintained to U. S. F. S. standards by me on Sept. 26, 1984.

REGISTERED PROFESSIONAL LAND SURVEYOR

William L. Hanley

OREGON JULY 14, 1978 WILLIAM L. HANLEY 1639

Office of.....County Surveyor..... County of..... Baker.....

State of.....Oregon....., I hereby certify that the within instrument was filed in this office for record on the..... day of....., 19.....

..... by (COUNTY OFFICIAL) (DEPUTY)