

CERTIFIED RECORD OF LAND CORNER MONUMENTATION


Y-Z-23

History of original corner establishment:

Corner established by W. L. Hanley and recorded under Baker County Survey No. 7-44-11, filed October 4, 1978.

Record of survey states:

Set a 5/8 inch x 30 inch rebar.

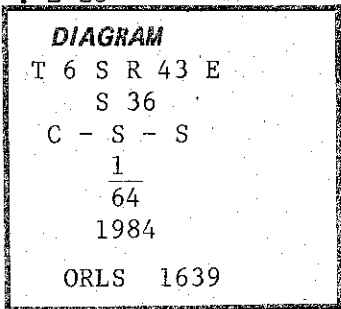

Description of corner evidence found:

Found a 5/8 inch x 30 inch rebar with yellow plastic cap marked R P E 2808.

NOTE: This found rebar bears N65°37'50"W, 30.82 ft dist from corner position established this survey.

Description of monument and accessories established to perpetuate the original location of this corner:

Set a 2½" aluminum cap on 2" aluminum pipe 31" long buried 27" in ground with 4" proj. from ground with surrounding rock mound and 6' steel fence post alongside with sign 54-9 attached. Buried rebar alongside.

Aluminum cap marked as shown in corner diagram.

New bearing trees established:

A fir 12 ins dia bears S68°W, 28.5 ft marked CSS1/64S36 BT.

A fir 12 ins dia bears N78°W, 27.4 ft marked CSS1/64S36 BT.

Each new bearing tree has a brass washer marked PLS 1639 nailed flush with BT blaze and has signs 54-3 and 54-9 attached below a 6 inch band of red paint.

I hereby certify that the above described corner monument was properly established by me on Nov. 13, 1984 and witnessed by Jim DeMastus and Daryl Schuchardt.

Jim DeMastus

**REGISTERED  
PROFESSIONAL  
LAND SURVEYOR**

*William L Hanley*

**OREGON  
JULY 14, 1978  
WILLIAM L. HANLEY  
1639**

Office of.....County Surveyor..... County of.....Baker.....  
State of.....Oregon....., I hereby certify that the within instrument was filed in this office  
for record on the..... day of....., 19.....

..... by .....  
(COUNTY OFFICIAL) (DEPUTY)

FILED 4-28-86  
BAKER COUNTY SURVEYOR  
SURVEY NO. 6-43-77