

CERTIFIED RECORD OF LAND CORNER MONUMENTATION


Y-Z-24

**History of original corner establishment:**

Corner established by W. L. Hanley and recorded under Baker County Survey No. 7-44-11, filed October 4, 1978.

**Record of survey states:**

Set a 5/8 inch x 30 inch rebar.

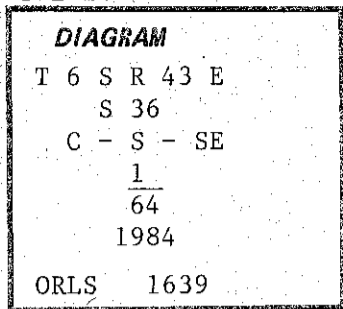

**Description of corner evidence found:**

Found a 5/8 inch x 30 inch rebar with yellow plastic cap marked R P E 2808.

NOTE: This found rebar bears N19°04'19"W, 0.40 ft dist from corner position established this survey.

**Description of monument and accessories I established to perpetuate the original location of this corner:**

Set a 2½" aluminum cap on 2" aluminum pipe 31" long buried 27" in ground with 4" proj. from ground with surrounding rock mound and 6' steel fence post alongside with sign 54-9 attached. Buried rebar alongside.

Aluminum cap marked as shown in corner diagram.

**New bearing trees established:**

A fir 8 ins dia bears S62°W, 54.4 ft marked CSSE1/64S36 BT.

A fir 6 ins dia bears S09°W, 35.3 ft marked CSSE1/64S36 BT.

Each new bearing tree has a brass washer marked PLS 1639 nailed flush with BT blaze and has signs 54-3 and 54-9 attached below a 6 inch band of red paint.

I hereby certify that the above described corner monument was properly established by me on Nov. 14, 1984 and witnessed by Jim DeMastus and Daryl Schuchardt.

Jim DeMastus

**REGISTERED  
PROFESSIONAL  
LAND SURVEYOR**

*William L Hanley*

**OREGON  
JULY 14, 1978  
WILLIAM L. HANLEY  
1639**

Office of..... County Surveyor..... County of..... Baker  
Oregon  
State of..... I hereby certify that the within instrument was filed in this office  
for record on the..... day of....., 19.....  
..... by .....  
(COUNTY OFFICIAL) (DEPUTY)

FILED 4-28-86  
BAKER COUNTY SURVEYOR  
SURVEY NO. 6-43-78