


CERTIFIED RECORD OF LAND CORNER MONUMENTATION

History of original corner establishment:

None, corner established this survey.

Z-24

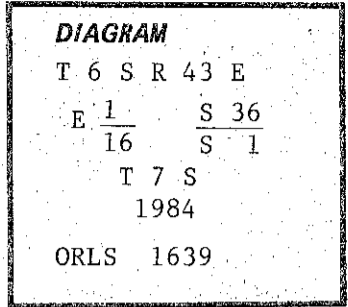

Description of corner evidence found:

None.

Description of monument and accessories established to perpetuate the original location of this corner:

Set a 2½" aluminum cap on 2" aluminum pipe 31" long buried 27" in ground with 4" proj. from ground with surrounding rock mound and 6' steel fence post alongside with sign 54-9 attached.

Aluminum cap marked as shown in corner diagram.

New bearing trees established:

A fir 17 ins dia bears S65°W, 99.2 ft marked E1/16S1 BT.

A fir 21 ins dia bears N36°E, 42.1 ft marked E1/16S36 BT.

Each new bearing tree has a brass washer marked PLS 1639 nailed flush with BT blaze and has signs 54-3 and 54-9 attached below a 6 inch band of red paint.

I hereby certify that the above described corner monument was properly established by me on Nov. 15, 1984 and witnessed by Jim DeMastus and Daryl Schuchardt.

Jim DeMastus

**REGISTERED
PROFESSIONAL
LAND SURVEYOR**

William L Hanley

**OREGON
JULY 14, 1978
WILLIAM L. HANLEY
1639**

Office of..... County Surveyor..... County of..... Baker
Oregon

State of....., I hereby certify that the within instrument was filed in this office
for record on the..... day of....., 19.....

..... by
(COUNTY OFFICIAL) (DEPUTY)