

CERTIFIED RECORD OF LAND CORNER MONUMENTATION

History of original corner establishment:


Original survey executed in 1940 by Gordon C. Smith under instructions dated October 4, 1940.

Set a basalt stone, 24"x10"x6", 18" in the ground, marked "B-1-F-1-868", from which:

A fir 14" diameter, bears S35W, 34' distance

A fir 18" diameter, bears S66W, 24.8' distance

Both marked "B-1-F-1-868 BT"

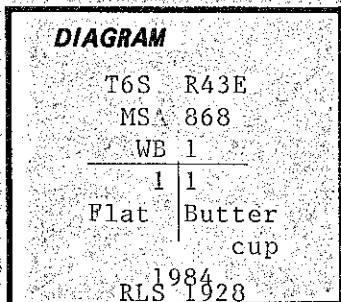

Description of corner evidence found:

21" fir S35W 34' scribed "B1-F1 868 BT"

26" twin fir S66E 24.8' scribed "B1-F1-868 BT"

Both with 54-3 & 54-4 tags and painted scribes and 6"bands.

Description of monument and accessories established to perpetuate the original location of this corner:

Set 30" aluminum pipe with 3 1/4" aluminum cap, marked as shown above, 14" above ground, in mound of rock. Buried old monument alongside aluminum cap.

Set steel post with 54-4 and 54-2 signs attached.

Repainted scars and 6" red bands on original BT's.

REGISTERED
PROFESSIONAL
LAND SURVEYOR
Duane Fehring
OREGON
JULY 13, 1984
DUANE FEHRINGER
2118

Office of..... County of.....
State of....., I hereby certify that the within instrument was filed in this office
for record on the..... day of....., 19....
..... by

(COUNTY OFFICIAL)

(DEPUTY)

FILED: May 9 1986
BAKER COUNTY SURVEYOR
SURVEY NO. 6-43-85