

CERTIFIED RECORD OF LAND CORNER MONUMENTATION

History of original corner establishment:


Original survey executed in 1940 by Gordon C. Smith under instructions dated October 4, 1940.

Set a galvanized iron pipe, 1" diameter, 36" long, 28" in the ground, marked "B-2-WB-2-868", from which:

A fir, 10" diameter, bears N2E, 32' distance

A tamarack, 12" diameter, bears S55E, 28.5' distance

Both marked "B-2-WB-2-868-BT"

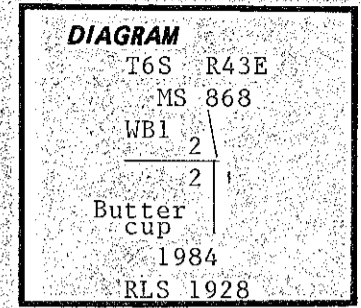

Description of corner evidence found:

18" dead fir N2E 32' with scribing visible

24" fir S55E 28.5' with scribing visible

Both with 54-3 & 54-4 tags attached.

Description of monument and accessories established to perpetuate the original location of this corner:

Set 30" long aluminum pipe with 3 1/4" aluminum cap, marked as shown above, 10" above ground. Buried old monument alongside aluminum cap. Set steel post with 54-4 & 54-2 signs attached. New cap set in mound of rock. Repainted scars & 6" red bands on original bearing trees.

REGISTERED
 PROFESSIONAL
 LAND SURVEYOR
Duane Fehringer
 1-20-86
 OREGON
 JULY 13, 1984
 DUANE FEHRINGER
 2118

Office of..... County of.....

State of....., I hereby certify that the within instrument was filed in this office

for record on the..... day of....., 19.....

..... by

(COUNTY OFFICIAL)

(DEPUTY)

FILED May 9, 1986
 BAKER COUNTY SURVEYOR
 SURVEY NO. 6-43-86