

CERTIFIED RECORD OF LAND CORNER MONUMENTATION

**History of original corner establishment:**


Original survey executed in 1940 by Gordon C. Smith under instructions dated October 4, 1940.

Set a basalt stone, 24"x12"x10", 18" in the ground, marked "B-3-868", from which:

A pine 14" diameter, bears S63E 36' distance

A pine 16" diameter, bears N39E 34.3' distance

Both marked "B-3-868 BT"

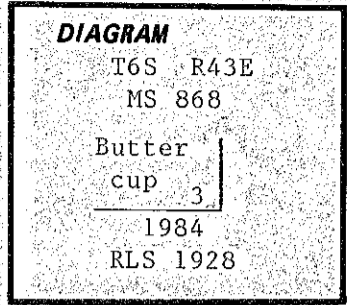

**Description of corner evidence found:**

Fallen pine S63E 36' with scribing legible

20" pine N39E 34.3' with scribing visible

Both with 54-3 & 54-4 tags & painted scribes & 6" red bands

**Description of monument and accessories I established to perpetuate the original location of this corner:**

Set 30" aluminum pipe with 3 1/4" aluminum cap, marked as shown above, 10" above ground, in mound of rock. Buried old monument alongside aluminum cap.

Set steel post with 54-4 and 54-2 signs attached.

Scribed:

8" fir S62W 8' "B-3-868 BT"

Repainted scars & 6" red bands on original BTs.

REGISTERED  
PROFESSIONAL  
LAND SURVEYOR  
1-20-86  
*Duane Fehringer*  
OREGON  
JULY 13, 1984  
DUANE FEHRINGER  
2118

Office of..... County of.....

State of....., I hereby certify that the within instrument was filed in this office

for record on the..... day of....., 19.....

..... by .....

(COUNTY OFFICIAL)

(DEPUTY)

FILED May 9, 1986  
BAKER COUNTY SURVEYOR  
SURVEY NO. 6-43-87