

CERTIFIED RECORD OF LAND CORNER MONUMENTATION

History of original corner establishment:


Original survey executed in 1940 by Gordon C. Smith under instructions dated October 4, 1940.

Set basalt rock, 24"x12"x6", in the ground, marked "B-4-F-2-868", from which:

A fir 26" diameter, bears S13W, 4' distance

A fir 30" diameter, bears N40E, 21.5' distance

Both marked "B-4-F-2-868 BT"

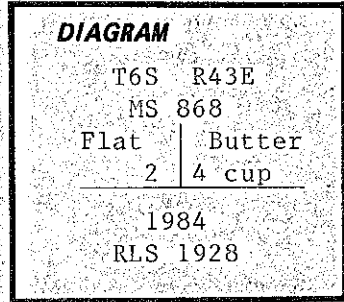

Description of corner evidence found:

30" low cut stump with scar & possible scribing visible - S13W - 4'

Found loose portion of old stump with "868 BT" legible

Description of monument and accessories I established to perpetuate the original location of this corner:

Set 30" aluminum pipe with 3/4" aluminum cap, marked as shown above, 8" above ground, buried in mound of rock. Buried old monument alongside aluminum cap. Set steel post with 54-4 and 54-2 signs attached.

Scribed:

7" fir S15W 36.7' "B4-F2-868-BT"

10" fir N14W 51.9' ""B4-F2=868-BT"

Attached signs 54-4 & 54-3 and nailed aluminum washers stamped "RLS 1928" by "BT" scribe on each tree. Painted blazes red and a 6" red band around BTs.

REGISTERED
PROFESSIONAL
LAND SURVEYOR
1-20-84
Duane Fehring
OREGON
JULY 13, 1984
DUANE FEHRINGER
2118

Office of..... County of.....
 State of....., I hereby certify that the within instrument was filed in this office
 for record on the..... day of....., 19....
 by
 (COUNTY OFFICIAL) (DEPUTY)

FILED May 9, 1986
 BAKER COUNTY SURVEYOR
 SURVEY NO. 6-43-88