

CERTIFIED RECORD OF LAND CORNER MONUMENTATION

History of original corner establishment:


Original survey executed by W. B. Barr in July 1884 under contract No. 503, dated May 23, 1884.

Set 4" diameter post 4' long, 24" in the ground marked "1/4 S" on West side.

From which: 5" fir bears N.65°E. 12 lks.

5" fir bears S.33°W. 30 lks.

Both scribed: "1/4 S BT"

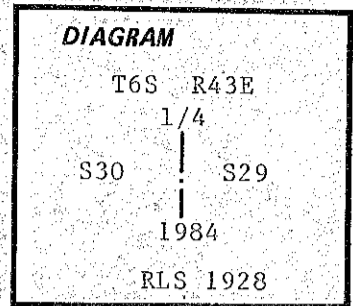

Description of corner evidence found:

NONE

Description of monument and accessories established to perpetuate the original location of this corner:

Set 30" long aluminum pipe with 3 1/4" aluminum cap, marked as shown above, 6" above ground. Steel post with 54-9 & 54-2 signs next to cap.

Scribed:

8" fir N.88°W. 9.4' "1/4 S30 BT"

5" fir N.15°E. 44.8' "1/4 S29 BT"

Attached signs 54-9 & 54-3 and nailed aluminum washers stamped "RLS 1928" by "BT" scribe on each tree. Painted blazes red and a 6" red band around both trees.

REGISTERED  
PROFESSIONAL  
LAND SURVEYOR  
1-20-86  
*Duane Fehring*  
OREGON  
JULY 13, 1984  
DUANE FEHRINGER  
2118

Office of..... County of.....

State of....., I hereby certify that the within instrument was filed in this office

for record on the..... day of....., 19.....

..... by .....

(COUNTY OFFICIAL)

(DEPUTY)

FILED May 9, 1986  
BAKER COUNTY SURVEYOR  
SURVEY NO. 6-43-90