


CERTIFIED RECORD OF LAND CORNER MONUMENTATION

History of original corner establishment:

Not previously established.

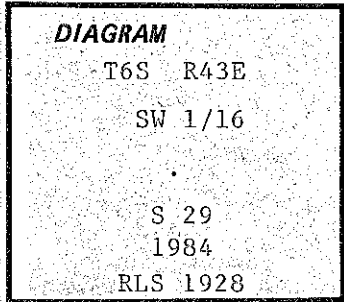

Description of corner evidence found:

Not previously established.

Description of monument and accessories established to perpetuate the original location of this corner:

Set 30" long aluminum pipe with 3 1/4" aluminum cap, marked as shown above, 8" above ground. Steel post with signs 54-9 & 54-2 set next to cap.

Scribed:

- 6" fir S.86°W. 4.3' "SW 1/16 S29 BT"
- 7" fir N.81°W. 16.5' "SW 1/16 S29 BT"

Attached signs 54-3 & 54-9 and nailed aluminum washers stamped "RLS 1928" by "BT" scribe on each tree. Painted blazes red and a 6" red band around both trees.

REGISTERED  
PROFESSIONAL  
LAND SURVEYOR  
1-20-86  
*Duane Fehringer*  
OREGON  
JULY 13, 1984  
DUANE FEHRINGER  
2118

Office of..... County of.....  
State of....., I hereby certify that the within instrument was filed in this office  
for record on the..... day of....., 19.....  
..... by .....

(COUNTY OFFICIAL)

(DEPUTY)

FILED May 9, 1986  
BAKER COUNTY SURVEYOR  
SURVEY NO. 6-43-94