


CERTIFIED RECORD OF LAND CORNER MONUMENTATION

History of original corner establishment:

Original corner established in 1884 by W. B. Barr under Contract #503. 4 ft. long post 4" in diameter set 24" in the ground.

- 15" Tamarack N47E 43 lks
18" Tamarack S58W 73 lks

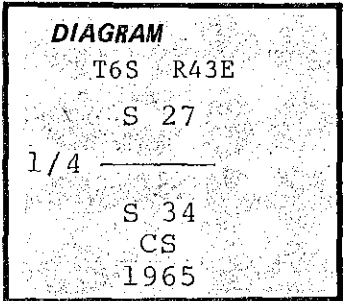

Description of corner evidence found:

Found aluminum cap marked as shown with attention sign on steel post, set by County Surveyor in 1965.

No bearing trees found.

Description of monument and accessories established to perpetuate the original location of this corner:


Scribed:

- 7" Pine "1/4 S27 BT" N10E 14.0 ft.
9" Pine "1/4 S34 BT" S29E 35.2 ft.

Attached signs 54-3 and 54-9.

Nailed an aluminum washer stamped "PLS 1928" on blaze above "BT" scribe. Bearing tree sign above blaze and land survey monument signs nailed to back of tree.

Painted the blazes red and a 6" red band around each tree above blaze.

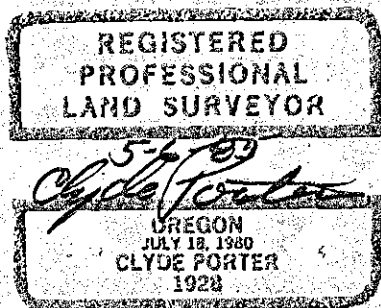

Office of... County of...
State of... I hereby certify that the within instrument was filed in this office
for record on the... day of... 19...

(COUNTY OFFICIAL) by (DEPUTY)

FILED May 9, 1986
BAKER COUNTY SURVEYOR
SURVEY NO. 6-43-96