

CERTIFIED RECORD OF LAND CORNER MONUMENTATION


History of original corner establishment:

Original corner established in 1884 by W. B. Barr under Contract #503.

Set a granite rock 15" x 12" x 10" with "1/4" marked on west side.

Scribed:

- 5" Pine N21E 26 lks
- 8" Pine N30W 33 lks

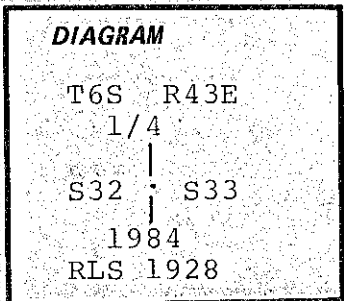

Description of corner evidence found:

Found a 23" fir that we cut out and found visible signs of scribing: "S44W 17.0 ft.

Found a tree stump that had been logged S28E 22.0 ft.

Set corner from these bearing trees and attached signs 54-3 and 54-9 to both.

Description of monument and accessories established to perpetuate the original location of this corner:

Set 30" aluminum pipe with 3 1/4" aluminum cap 10" above ground with rockpile to base of cap marked as shown above.


Scribed:

- 6" Fir "1/4 S33 BT" S14E 36.2 ft.
- 19" Fir "1/4 S32 BT" N40W 38.8 ft.

Nailed aluminum washers stamped "PLS 1928" above "BT" scribe on both trees.

Nailed bearing tree signs above blaze and land survey monument signs on back of each tree.

Painted blazes red and a 6" red band above blaze on all bearing trees.

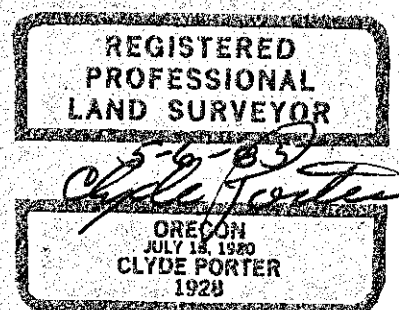

Office of..... County of.....
 State of....., I hereby certify that the within instrument was filed in this office
 for record on the..... day of....., 19.....

(COUNTY OFFICIAL)

(DEPUTY)

FILED May 9, 1986
 BAKER COUNTY SURVEYOR
 SURVEY NO. 6-43-105