

CERTIFIED RECORD OF LAND CORNER MONUMENTATION


History of original corner establishment:

Original corner established in 1884 by  
W. B. Barr under Contract #503.

Set 4' post 4" in diameter 24" in the ground marked  
"1/4S" on West side.

Scribed:

26" Pine N70W 52 lks  
5" Fir S45E 53 lks

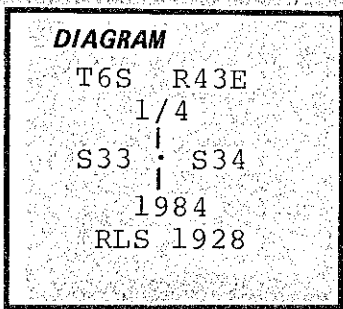

Description of corner evidence found:

None

Description of monument and accessories established to perpetuate the original location of this corner:

Set 30" aluminum pipe with 3/4" aluminum cap 10" above ground marked as shown above.


Steel post 3' south with signs 54-9 and 54-4 scribed:

5" Fir "1/4 S33 BT" S75W 16.9 ft.  
10" Fir "1/4 S34 BT" S32E 39.5 ft.

Nailed aluminum washers stamped "PLS 1928" above "BT" scribe on both trees.

Nailed bearing tree signs above blaze and land survey monument signs on back of each tree.

Painted blazes red and a 6" red band above blaze on both trees.

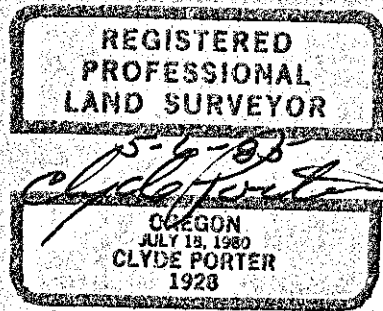

Office of..... County of.....  
State of....., I hereby certify that the within instrument was filed in this office  
for record on the..... day of....., 19....

(COUNTY OFFICIAL)

(DEPUTY)

FILED May 9, 1986  
BAKER COUNTY SURVEYOR  
BOOK NO. 6-43-108