


CERTIFIED RECORD OF LAND CORNER MONUMENTATION

History of original corner establishment:

Corner not previously established.

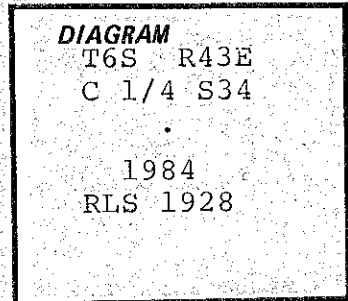

Description of corner evidence found:

Corner not previously established.

Description of monument and accessories | established to perpetuate the original location of this corner:

Set 30" aluminum pipe with a 3 1/2" aluminum cap marked as shown above.
Steel post 2' east with signs 54-9 and 54-2.


Scribed:

- 6" Fir "C 1/4 S34 BT" N90E 8.0 ft.
- 6" Fir "C 1/4 S34 BT" N82W 17.8 ft.

Nailed aluminum washers stamped "RLS 1928" above "BT" scribed on both trees.

Nailed bearing tree signs above blaze and a land survey monument sign on back of both trees.

Painted blazes red and a 6" red band above blaze on each tree.

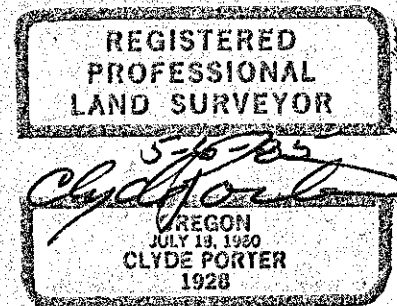

Office of..... County of.....
 State of....., I hereby certify that the within instrument was filed in this office
 for record on the..... day of....., 19.....
 by
 (COUNTY OFFICIAL) (DEPUTY)

FILED May 9, 1980
 BAKER COUNTY SURVEYOR
 SURVEY NO. 6-43-109