

CERTIFIED RECORD OF LAND CORNER MONUMENTATION


History of original corner establishment:

Original corner established in 1884 by W. B. Barr under Contract #503.

Set 4' long post 4" in diameter 24" in the ground.

Scribed:

- 7" Fir N43E 40 lks
- 5" Fir N50W 47 lks

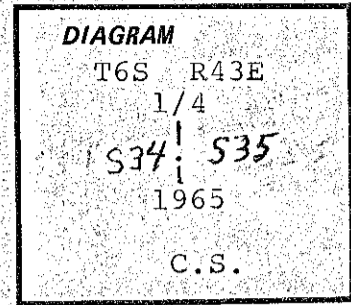

Description of corner evidence found:

Found 1" aluminum pipe with cap 10" above ground marked as shown above.

Old snag with red band and 54-3 sign attached reads: S45W 40 lks
No visible markings.

24" Fir with red band and signs 54-2 and 54-9 attached.
54-3 sign attached reads: S50E 47 lks
No visible markings.

Description of monument and accessories | established to perpetuate the original location of this corner:


Scribed:

- 9" Fir "1/4 S35 BT" S72E 59.5 ft.
- 9" Fir "1/4 S34 BT" N82W 3.8 ft.

Nailed aluminum washers stamped "RLS 1928" above "BT" scribe on each tree.

Nailed bearing tree signs above blaze and a land survey monument sign on back of both trees.

Painted blazes red and a 6" red band on both trees above blaze.

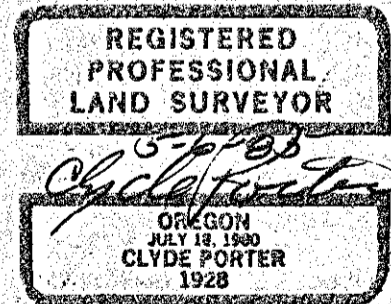

Office of..... County of.....

State of....., I hereby certify that the within instrument was filed in this office for record on the..... day of....., 19.....

..... by
(COUNTY OFFICIAL) (DEPUTY)

FILED May 9, 1986
BAKER COUNTY SURVEYOR
SURVEY NO. 6-43-110